

KANSAS

Rush

FORM 51 IOM 12-46 PETROL

Section 34 Township 19 Range 16-W

Well No. 3 Hagerman

Company Gulf

Ryan Pool

NORTH

10

WEST

EAST

SOUTH

KANSAS

Rush

Sec. 34 Twp. 19 R. 16-W

Well No. 3 Hagerman Farm
Gulf Company

Ryan Pool


990 Ft. from N. Line

_____ Ft. from S. Line

_____ Ft. from E. Line

990 Ft. from W. Line

SE NW SE

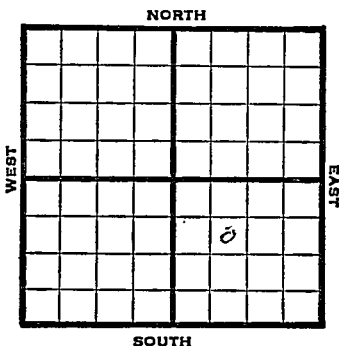

1947	Elev. 2008 REPORT
8/13	Loc.
8/20	"
8/27	"
9/3	"
9/10	8" @ 1043' Drlg. 2353'
9/17	Arbuckle 3687' Drlg. 3738'
9/24	SLM 3737-3712' Arbuckle 3666' TD 3743' 5" @ 3741' RUST
10/1	Swab 1 $\frac{1}{2}$ bbls. oil PH
10/8	Flow 12 bbls oil PH, 5 hrs. 1/2" choke TD 3746'
10/15	Arbuckle 3666 5" @ 3741 1000 Acid Bon & Pot. 1761 TD 3746 Gravity 38.7

COMPLETED

Map No. _____ Sec. 34 Twp. 19 R. 16W

Well No. 3 Hagerman

Gulf Company

FIRST REPORT Contractor

SE NW SE

SECTION PLAT

990 Ft. from N. Line

_____ Ft. from S. Line

_____ Ft. from E. Line

990 Ft. from W. Line

Rush County

Location X

Rig up _____

Drilling and Remarks:

RECORD

Cased _____ in., _____ ft.

Sand _____

Gas _____

Oil _____

Total Depth _____

PRODUCTION

1st 24 hrs. Nat. _____

1st 24 hrs. after shot _____

Gas _____ Cu. Ft.

Dry Hole _____

Abandoned _____

Date

AUG 13 1947 19

S. J. LEWIS Scout

