


Section 34 Township 19 Range 16W

Well No. #3 Nagel

Company Alkay

Ryan Pool

NORTH

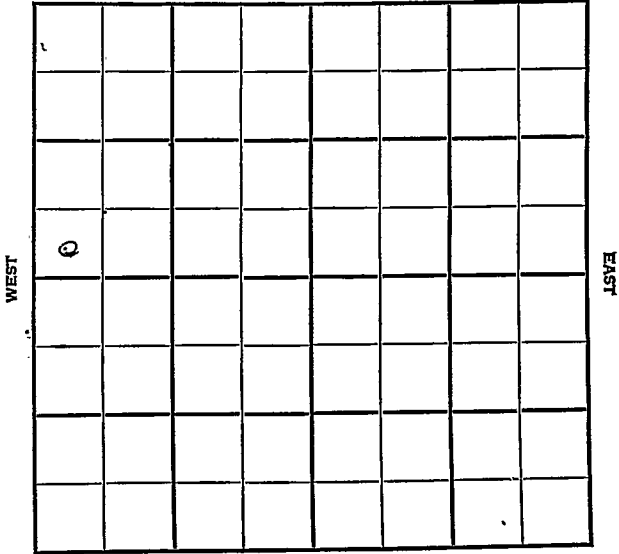

SOUTH

Sec. 34 Twp. 19 R. 16W

Well No. #3 Nagel Farm

Alkay Company


Ryan

 Ft. from N. Line

330 Ft. from S. Line

 Ft. from E. Line

330 Ft. from W. Line

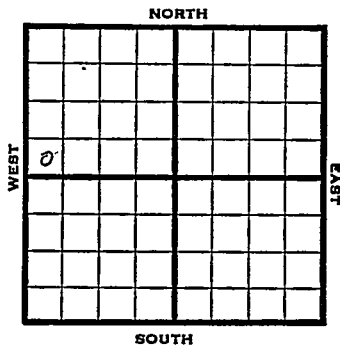

SW NW

1948 Eli 2030' REPORT

- 4/14 Location
- 4/21 "
- 4/28 "
- 5/5 "
- 5/12 "
- 5/19 "
- 5/26 RUR
- 6/1 "
- 6/9 "
- 6/16 "
- 6/23 "
- 6/29 "
- 7/14 Location
Abandoned
ABANDONED

Map No. _____ Sec. 34 Twp. 19 R. 16^WWell No. 3 NagelAlkay Company

FIRST REPORT

Contractor

SW NW

SECTION PLAT

o			

_____ Ft. from N. Line

330 Ft. from S. Line

_____ Ft. from E. Line

330 Ft. from W. LineRush CountyLocation X

Rig up _____

Drilling and Remarks:

RECORD

Cased _____ in., _____ ft.

Sand _____

Gas _____

Oil _____

Total Depth _____

PRODUCTION

1st 24 hrs. Nat. _____

1st 24 hrs. after shot _____

Gas _____ Cu. Ft.

Dry Hole _____

Abandoned _____

Date

APR 14 1948 19 _____ S. J. LEWIS Scout

Map No. 81 Sec. 34 Twp. 19 R. 16W

Well No. 3 Nagel

Alkay Company

ABANDONED

Contractor

SW NW

E. 2030
SECTION PLAT

 Ft. from N. Line

330 Ft. from S. Line

 Ft. from E. Line

330 Ft. from W. Line

0			

Rush County

Location ✓

Rig up

Drilling and Remarks:

RECORD

Cased in., ft.

Sand

Gas

Oil

Total Depth

PRODUCTION

1st 24 hrs. Nat.

1st 24 hrs. after shot

Gas Cu. Ft.

Dry Hole

Abandoned

Date

JUL 14 1948 19

S. J. LEWIS Scout