

KANSAS

Rush

FORM 51 IOM 12-46 PETROL

Section 34 Township 19 Range 16W

Well No. 1 Rankin

Company Magnolia

2

Ryan

NORTH

WEST

EAST

SOUTH

KANSAS

Rush

Sec. 34 Twp. 19 R. 16WWell No. #1 Rankin FarmMagnolia Company

Ryan

NORTH

990

Ft. from N. Line


Ft. from S. Line

Ft. from E. Line

990

Ft. from W. Line

SE NW NE

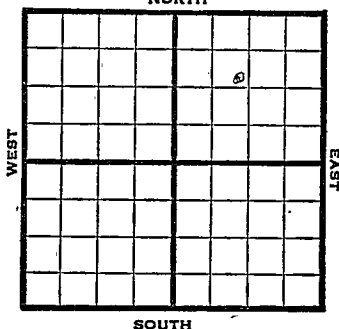

1947 Elev. 1999 REPORT

9/10 Location

9/17 8" @ 140'
WOC

9/24 Drlg. 3310'

10/1 Lansing 3393'
Arbuckle 3673'
TD 3731'
Set 5% @ 3731'10/8 TD 3742'
Swb 9 bbls oil in 10 hrs.10/15 Arbuckle 3673
5" @ 3731
500 Acid
Glow 41 oil Pot.
8 M Gas
TD 3742
Gravity 39

COMPLETED

Map No. _____ Sec. 34 Twp. 19 R. 16W

Well No. 1 Rankin

Magnolia Company

FIRST REPORT Contractor

SE NW NE


SECTION PLAT

990 Ft. from N. Line

_____ Ft. from S. Line

_____ Ft. from E. Line

990 Ft. from W. Line

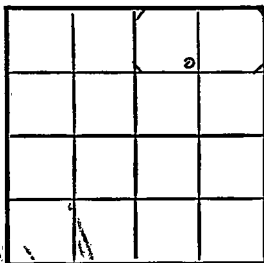

Rush County

RECORD

Location X

Cased _____ in, _____ ft.

Rig up _____

Sand _____

Drilling and Remarks:

Gas _____

Oil _____

Total Depth _____

PRODUCTION

1st 24 hrs. Nat. _____

1st 24 hrs. after shot _____

Gas _____ Cu. Ft.

Dry Hole _____

Abandoned _____

Date

SEP 10 1947 19 S. J. LEWIS Scout

Map No. 81 Sec. 34 Twp. 19 R. 16

Well No. 1 Rankin

Magnolia Company

COMPLETE

Contractor

SE NW NE

E11999


SECTION PLAT

990 Ft. from N. Line

 Ft. from S. Line

 Ft. from E. Line

990 Ft. from W. Line

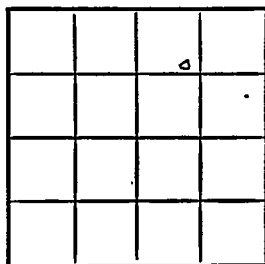

Rush County

Location

Rig up

Drilling and Remarks:

*Re 8862
5" casing
5000 cu ft*

Flow 4/10/47

SM Gas

8908

RECORD

Cased in., ft.

Sand

Gas

Oil

Total Depth 5242

PRODUCTION

1st 24 hrs. Nat.

1st 24 hrs. after shot

Gas Cu. Ft.

Dry Hole

Abandoned

Date

OCT 15 1947 19

S. J. LEWIS

Scout