


Section 34 Township 19 Range 16 WWell No. # 5 HagermanCompany M. Wunderlich

12

NORTH

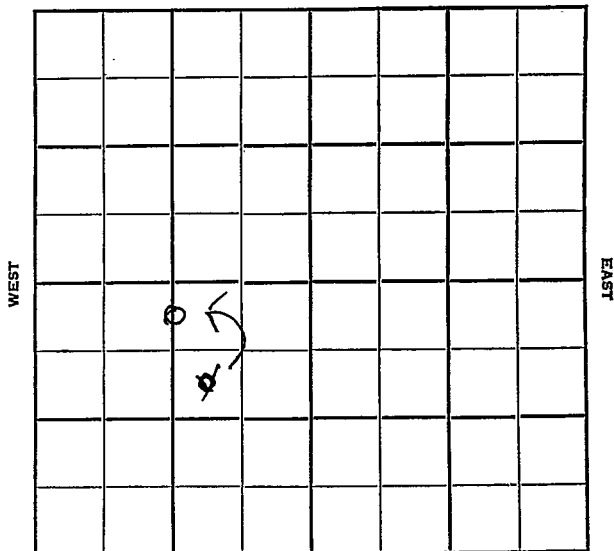

SOUTH

Rush

KANSAS



Sec. 34 Twp. 19 R. 16 W

Well No. # 5 Hagerman Farm

M. Wunderlich Company

H. M. Williams Contractor

330

990 Ft. from N. Line

Ft. from S. Line


1320

990 Ft. from E. Line

Ft. from W. Line

~~SW NE SW~~

c n r sub 4

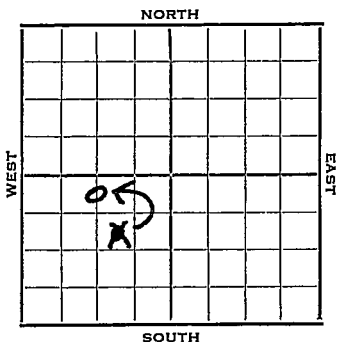

1952 Elev. 2025' REPORT

4/9 Spud 4-2-52
8" @ 1077' WOC

4/23 Lans. 3400 Drlg. 3570'

4/30 Arb. 3711 RTD 3721
4" @ 3714 DP DD 3725 gas
DD 3726' lost bailer.

5/7 Lost bailer Fishing.

5/14 Drlg. 3732'

5/21 Drlg. 3734'

5/28 DD 3751' TD 2500 A

6/4 Spud 4-2-52
Oil well TD 3751' 8" @ 1077'
Lans. 3400' Arb. 3711' TD 3721'
4 1/2" @ 3714' DD 3725' DD 3736'
15 qt/ DD 3751' 2500 A
Comp. 50 BOPD


COMPLETED

County Rush State Kansas
 Sec. 34 (Blk.) 19 (Sur.) 16W Map No.

Operator M. Wunderlich

Well No. 5 Farm Hagerman

Elev. _____ Location SW NE SW

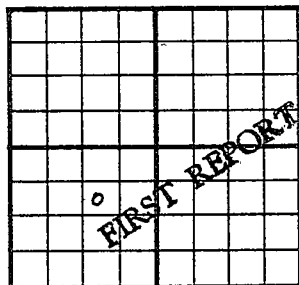

990 Ft. From N Line SW

990 Ft. From E Line Quarter

1st. Report APR 9 1952

Completion _____

Remarks _____

H. M. Williams - Contr.

Spudding Date 4-2-52

Drlg. Data _____

8" @ 1077 WOC

J. G. McGEHEE

Kansas

Map No. _____ Sec. 34 Twp. 19 R. 16WWell No. 5 HagermanM. Wunderlich CompanyC N L SW/4 ~~CORRECTION~~ Contractor

SECTION PLAT

330 Ft. from N. Line Ft. from S. Line1320 Ft. from E. Line Ft. from W. Line

Rush County

Location _____

Rig up _____

Drilling and Remarks:

Reported

SW NE SW

RECORD

Cased _____ in., _____ ft.

Sand _____

Gas _____

Oil _____

Total Depth _____

PRODUCTION

1st 24 hrs. Nat. _____

1st 24 hrs. after shot _____

Gas _____ Cu. Ft.

Dry Hole _____

Abandoned _____


Date

JUN 18 1952

19

J. G. McGEHEE Scout

County Rush State Kansas
 Sec. 34 (Blk.) 19 (Sur.) 16W Map No.
 Operator M. Wunderlich
 Well No. 5 Farm Hagerman
 Elev. 2025 Location C N L SW/4

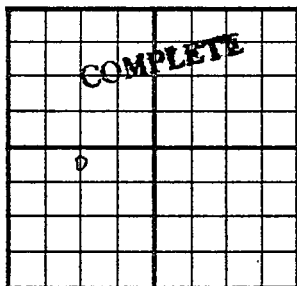

330 Ft. From N Line SW
1320 Ft. From E Line Quarter
 1st. Report

Completion JUN 4 1952

Remarks

H.M. Williams - Contr.

Spudding Date 4-2-52

Drilg. Data Oil well TD 3751
8" @ 1077 Lans. 3400 Arb. 3711
TD 3721 4 1/2" @ 3714 DD 3725 DD 3736
15 qt/ DD 3751 2500 A
Comp. 50 bopd

J. G. McGEHEE