


Section 34 Township 19 Range 16 WWell No. # 6 HagermanCompany Martin Wunderlich

NORTH

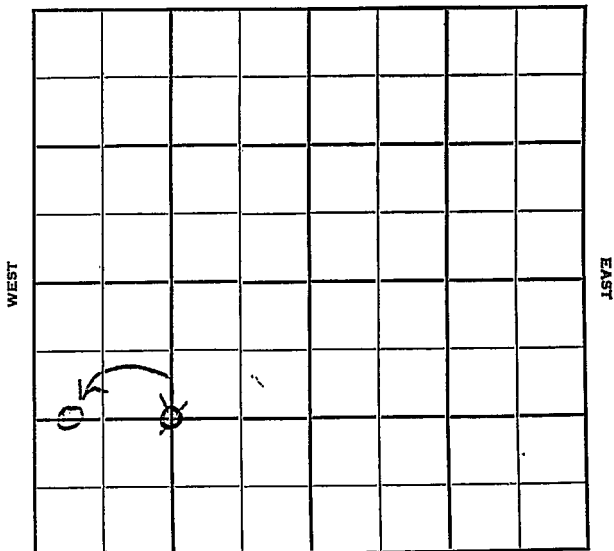

SOUTH

Rush

KANSAS

Sec. 34 Twp. 19 R. 16 W

Well No. # 6 Hagerman Farm

Martin Wunderlich Company

Williams Contractor

Rein Pool

 Ft. from N. Line


1320 Ft. from S. Line

 Ft. from E. Line

330
1320 Ft. from W. Line

~~SW/4~~

cw & w/2 sw

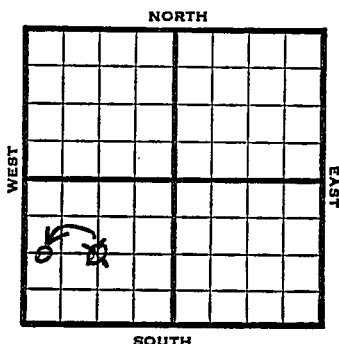

1952 Elev. 2012' REPORT

6/4 Location
6/11 13" @ 1070'
6/18 Pipe caved @ 400
6/25 Drlg.- 748'
7/2 Anhy 1063' Drlg. 2910
7/9 5" @ ?
7/17 NR
7/23 Cong. 3 676 Arb. 3702-19 TD
4" @ 3714' CO 3719
S/ 56 Bo 6 hrs.
7/30 NR
8/6 "
8/13 Spud 6-4-52
Oil Well TD 3719 13" @ 1070
Anhy 1063 Cong. 3676
Arb. 3702
4" @ 3714' TD 3719 S/ 56 bo
6 hr. Comp. 25 bopd 75 bw

COMPLETED

Map No. _____ Sec. 34 Twp. 19 R. 16WWell No. 6 Hagerman

M. Wunderlich _____ Company

CORRECTION _____ ContractorC W L $W\frac{1}{2}$ SW

SECTION PLAT

_____ Ft. from N. Line

1320 Ft. from S. Line

_____ Ft. from E. Line

330 Ft. from W. Line

Rush County

Location _____

Rig up _____

Drilling and Remarks:

Reported

C SW/4

RECORD

Cased _____ in., _____ ft.

Sand _____

Gas _____

Oil _____

Total Depth _____

PRODUCTION

1st 24 hrs. Nat. _____

1st 24 hrs. after shot _____

Gas _____ Cu. Ft.

Dry Hole _____


Abandoned _____

Date

JUN 11 1952 19

I. G. McGEHEE

Scout

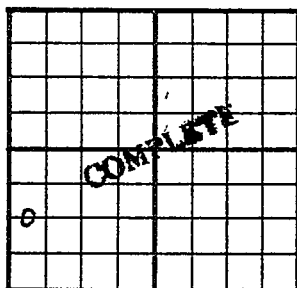County Rush State KansasSec. 34 (Blk. Twp.) 19 (Sur. Rge.) 16W Map No.Operator Martin WunderlichWell No. 6 Farm HagermanElev. 2012 Location C W $\frac{1}{2}$ W $\frac{1}{2}$ SW1320Ft. From S Line SW330Ft. From W Line Quarter

1st. Report

Completion AUG 13 1952Remarks Ryan PoolWilliams - Contr.Spudding Date 6-4-52Drig. Data Oil well TD 371913" @ 1070 Anhy 1063 Cong. 3676Arb. 3702 4" @ 3714 TD 3719S/ 56 bo 6 hr. Comp. 25 bopd 75 bw