

KANSAS


Rush

Section 34 Township 19S Range 16W

Well No. #3 Nagel

Company Alkay Oil

5

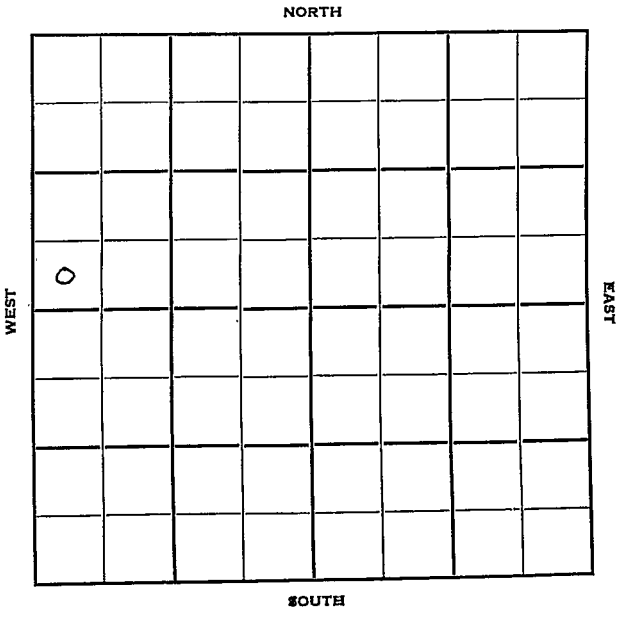

Sec. 34 Twp. 19 R. 16-W

Well No. #3 Nagel Farm _____

Alkay Oil Company


Cont. — Overland
Ryan Pool
Ft. from N. Line _____

330 Ft. from S. Line

_____ Ft. from E. Line

330 Ft. from W. Line

SW NW

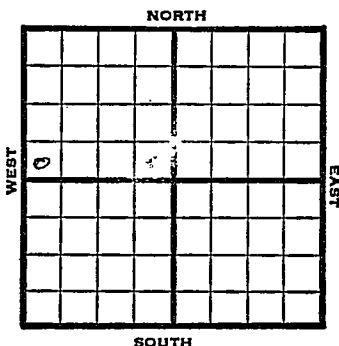

1949 Elev 2058' REPORT

10/5	8" @ 1090'
10/12	Drlg 1941'
10/19	Drlg 3250'
10/26	TD 3762'
	5" @ 3754'
11/1	"
11/8	Arbuckle 3747'
	TD 3772'
	800 acid
	Swb 8 bbls oil & wtr.
11/16	"
11/23	1000 acid
	Pump 5 bbls oil PH
11/29	2000 acid
12/7	TD 3772'
	Arb. 3747'
	5" @ 3754'
	3800 acid
	Pump 30 Oil / 20% W Pot
	40° Gr.
	Comp

COMPLETED

Map No. _____ Sec. 34 Twp. 19 R. 16W

Well No. 3 Nagel

Alkay Oil Company

Overland Contractor

FIRST REPORT
SECTION PLAT

SW NW

_____ Ft. from N. Line

330 Ft. from S. Line

_____ Ft. from E. Line

330 Ft. from W. Line

o			

Rush County

Location _____

Rig up _____

Drilling and Remarks:

8" @ 1090

RECORD

Cased _____ in., _____ ft.

Sand _____

Gas _____

Oil _____

Total Depth _____

PRODUCTION

1st 24 hrs. Nat. _____

1st 24 hrs. after shot _____

Gas _____ Cu. Ft.

Dry Hole _____

Abandoned _____

Date

OCT 5 1949 19

S. J. LEWIS Scout

Map No. _____ Sec. 34 Twp. 19 R. 16W

Well No. 3 Nagel

Alkay Oil Company

COMPLETE

Contractor

SW NW

P/2058
SECTION PLAT

_____ Ft. from N. Line

330 Ft. from S. Line

_____ Ft. from E. Line

330

_____ Ft. from W. Line

Rush County

Location _____

Rig up _____

Drilling and Remarks:

Cor 43747
5" @ 3757
38000000
Run 3000 ft + 20% W
Box
H 1700

RECORD

Cased _____ in., _____ ft.

Sand _____

Gas _____

Oil _____

Total Depth 3772

PRODUCTION

1st 24 hrs. Nat. _____

1st 24 hrs. after shot _____

Gas _____ Cu. Ft.

Dry Hole _____

Abandoned _____

Date

DEC 7 1949

19

S. J. LEWIS

Scout