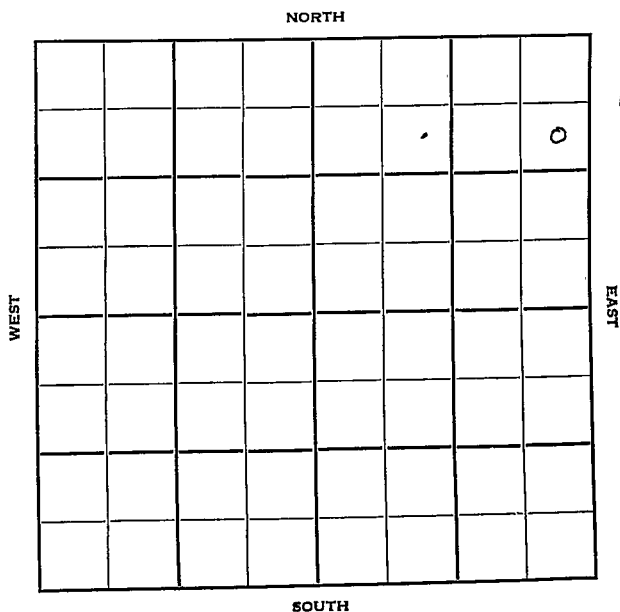


Section 34 Township 19 Range 16-WWell No. #1 RankinCompany Magnolia

Rush

KANSAS

Sec. 34 Twp. 19 R. 16W

Well No. #4 Rankin Farm

Magnolia Company

Barnett Drlg. Contractor


990' Ft. from N. Line

 Ft. from S. Line

330' Ft. from E. Line

 Ft. from W. Line

SE NE NE

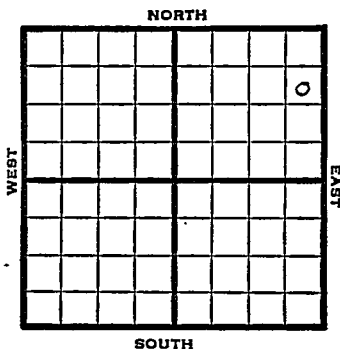

1950

Elev 2007

REPORT

6/14

Spud 6-10-50

Drlg. 845'

7/19

8" @ 1050

Lans 3407

Arb 3695-3741

5" @ 3738

TD 3751

CO 3741

B/10 boph

DD 3747

15 boph

1000 acid

10 bopd

DD 3749

S/3½ boph

DD 3751

1500 acid

Comp 39 bopd

Completed

COMPLETED

Map No. _____ Sec. 34 Twp. 19 R. 16WWell No. 4 Rankin_____ Magnolia _____ Company_____ Barnett Drlg. _____ Contractor

SE NE NE

SECTION PLAT


990 Ft. from N. Line

_____ Ft. from S. Line

330 Ft. from E. Line

_____ Ft. from W. Line

Rush County

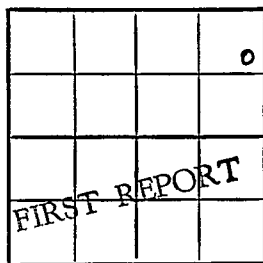

Location _____

Rig up _____

Drilling and Remarks:

Spud 6-10-50

drlg. 845

RECORD

Cased _____ in., _____ ft.

Sand _____

Gas _____

Oil _____

Total Depth _____

PRODUCTION

1st 24 hrs. Nat. _____

1st 24 hrs. after shot _____

Gas _____ Cu. Ft.

Dry Hole _____

Abandoned _____

Date

JUN 14 1950 19J. E. TYRA Scout


Kansas

Map No. _____ Sec. 34 Twp. 19 R. 16WWell No. 4 RankinMagnolia

Company _____

Contractor _____

SE NE NE

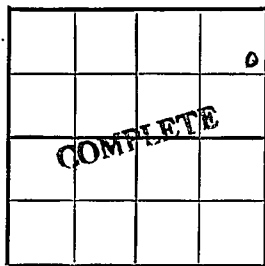E1. 2007
SECTION PLAT990 Ft. from N. Line Ft. from S. Line330 Ft. from E. Line Ft. from W. LineRush County

Location _____

Rig up _____

Drilling and Remarks:

8" @ 1050

Lans. 3407

Arb. 3695-3741

5" @ 3738

CO 3741

B/ 10 goph

DD 3747

RECORD

Cased _____ in., _____ ft.

Sand _____

Gas _____

Oil _____

Total Depth 3751

PRODUCTION

1st 24 hrs. Nat. _____

1st 24 hrs. after shot _____

Gas _____ Cu. Ft.

Dry Hole _____

Abandoned _____

Date

JUL 19 1950

19

J. E. TYRA

Scout

15 goph

DS1000 acid

10 bopd


DD 3749

S/ 3½ boph

DD 3751

1500 acid

Comp. 39 bopd

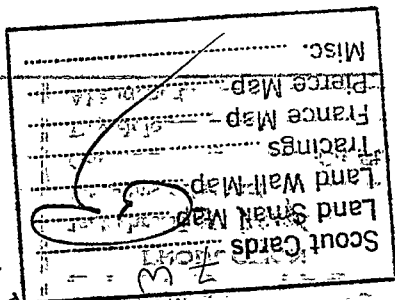

1950

AUG 1

SECTION 1441

COMMISSION

1950

1950

1950