

# KANSAS


FORM 51 5M PETROL

Barton

Section 35 Township 19 Range 11-W

Well No. #2 Galliard

Company Hershey

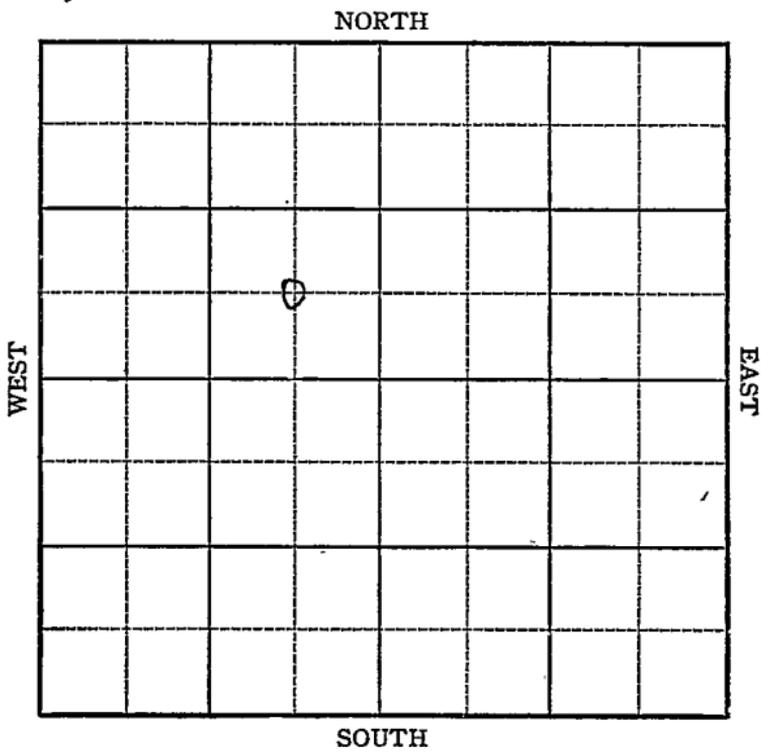

Sec. 35 Twp. 19 R. 11-W

Well No. #2 Galliard Farm

Hershey Company


\_\_\_\_\_ Ft. from N. Line

660 Ft. from S. Line

660 Ft. from E. Line

\_\_\_\_\_ Ft. from W. Line

*Elev. 1770*

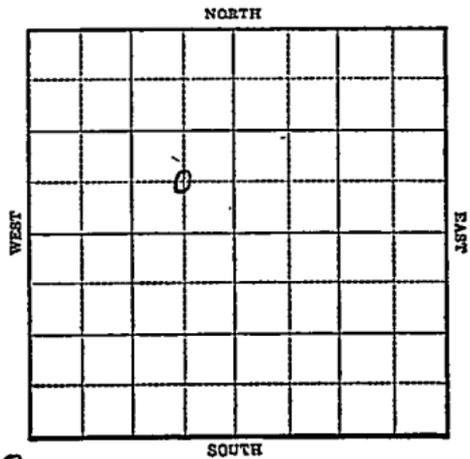

1943

R E P O R T

- 10/6 Rotary
- 10/13 8" @ 202'  
Drlg. 1000'
- 10/20 Drlg. 2830  
Anhy 512
- 10/27 Lans 3041  
Arb 3313  
T.D. 3316-  
5" @ 3313
- 11/3 Rust  
"
- 11/10 T.D. 3349 to acidize
- 11/17 2500 acid no help  
10 shots 3118-30 VS SO
- 12-1 5" @ 3313  
Arb 3313  
TD 3349

**ABANDONED**

Barton

**KANSAS**

Map No. 46 Sec. 35 Twp. 19 R. 11 W

Well No. 2 Galliant

Hershey

Company

**FIRST REPORT**

Contractor

**C SE NW**

**SECTION PLAT**

\_\_\_\_\_ Ft. from N. Line

660 Ft. from S. Line

660 Ft. from E. Line

\_\_\_\_\_ Ft. from W. Line

	o		
			/

**Silica Pool**

Location \_\_\_\_\_

Rig up \_\_\_\_\_

Drilling and Remarks:

**Rotary**

**RECORD**

Cased \_\_\_\_\_ in., \_\_\_\_\_ ft.

Sand \_\_\_\_\_

Gas \_\_\_\_\_

Oil \_\_\_\_\_

Total Depth \_\_\_\_\_

**PRODUCTION**

1st 24 hrs. Nat. \_\_\_\_\_

1st 24 hrs. after shot \_\_\_\_\_

Gas \_\_\_\_\_ Cu. Ft.

Dry Hole \_\_\_\_\_

Abandoned \_\_\_\_\_

Date

OCT 6 1943 19

**S. J. LEWIS**

Scout

Map No. KANS. 46 Sec. 35 Twp. 19 R. 11W

Well No. 2 Galliard

Hershey Company

ABANDONED Contractor

C SE NW

SECTION PLAT

         Ft. from N. Line

660 Ft. from S. Line

660 Ft. from E. Line

         Ft. from W. Line

	o		

Silica Pool

Location         

Rig up         

Drilling and Remarks:

*Cur 3313*

*5" @ 3313*

RECORD

Cased          in.,          ft.

Sand         

Gas         

Oil         

Total Depth 3349

PRODUCTION

1st 24 hrs. Nat.         

1st 24 hrs. after shot         

Gas          Cu. Ft.

Dry Hole         

Abandoned         

Date

DEC 1 1943 19

S. J. LEWIS Scout