


Section 35 Township 19 **KANSAS** Range 11-W

Well Number 1 H.C. Burmeister

Company Stanolind

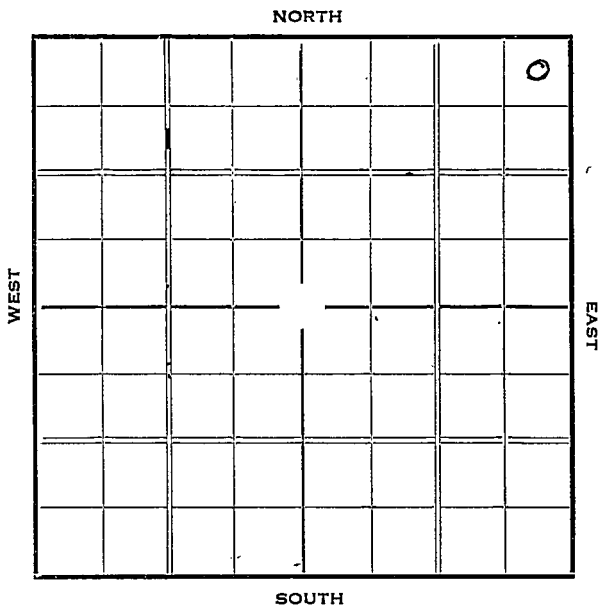

Sec. 35 Twp. 19 R. 11-W

Well No. #1 H. C. Burmeister Farm
Stanolind Company


330 Ft. from N. Line

_____ Ft. from S. Line

330 Ft. from E. Line

_____ Ft. from W. Line

Elev. 1768.

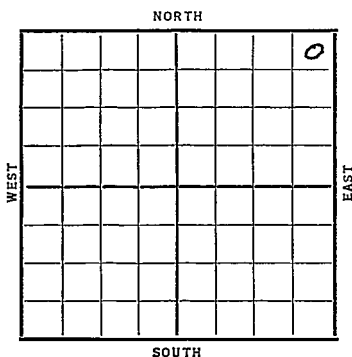

Date	REPORT
11/25	Location
12/3	Rigging upl
12/10	13" @ 200'. Anhydrate. Drlg. 535'.
12/17	Sil. 3305'. T. D. 3308'. Show saturation.
12/24	RUST.
12/29	T. D. 3345'. P. B. 3330'.
1937	
1/7	P. B. 3317½'. Trying to acidize.
1/14	3000 acid. but did not help.
1/20	Sil. 3305'. T. D. 3345'. 3000 acid. D & A
	<u>ABANDONED</u>

Map No. 46 Sec. 35 Twp. 19 R. 11W

Well No. L. H. C. Burmeister

Stanolind Company

Contractor

SECTION PLAT

			o

330 Ft. from N. Line

_____ Ft. from S. Line

330 Ft. from E. Line

_____ Ft. from W. Line

FIRST REPORT

Location ✓

Rig up _____

Drilling and Remarks:

RECORD

Cased _____ in., _____ ft.

Sand _____

Gas _____

Oil _____

Total Depth _____

PRODUCTION

1st 24 hrs. Nat. _____

1st 24 hrs. after shot _____

Gas _____ Cu. Ft.

Dry Hole _____

Abandoned _____

Date

NOV 25 1919

S. J. LEWIS

Scout

Map No. 46 Sec. 35 Twp. 19 R. 11W

Well No. 140 Burmeister

Standard Oil Co. Company

Contractor

SECTION PLAT

			0

330 Ft. from N. Line

_____ Ft. from S. Line

330 Ft. from E. Line

_____ Ft. from W. Line

ABANDONED

RECORD

Location _____

Cased _____ in., _____ ft.

Rig up _____

Sand _____

Drilling and Remarks:

Gas _____

*Si 13305
3000 acid
JVA*

Oil _____

Total Depth 3345

PRODUCTION

1st 24 hrs. Nat. _____

1st 24 hrs. after shot _____

Gas _____ Cu. Ft.

Dry Hole _____

Abandoned _____

Date

N 20 1937 19

S. J. LEWIS Scout