

KANSAS

Barton County

FORM 51 IOM 12-46 PETROL


Section 35 Township 19 Range 11-W

Well No. 1 Burmeister "B"

Company Eldorado Ref. et al

Silica Pool

NORTH

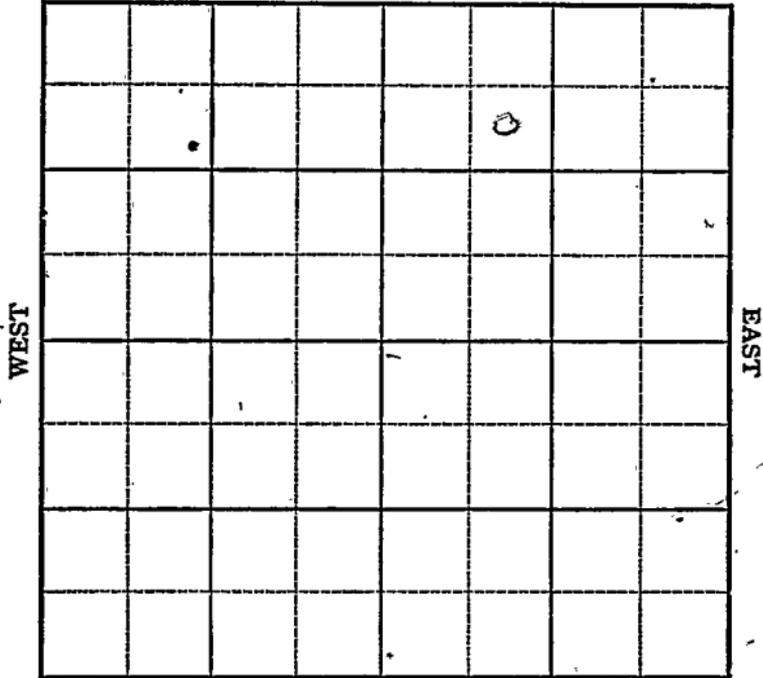

SOUTH

Sec. 35 Twp. 19 R. 11-W

Well No. #1 Burmeister "B" Farm

Eldorado Ref. etal. Company

Silica Pool


990 Ft. from N. Line

\_\_\_\_\_ Ft. from S. Line

\_\_\_\_\_ Ft. from E. Line

990 Ft. from W. Line

SE NW NE

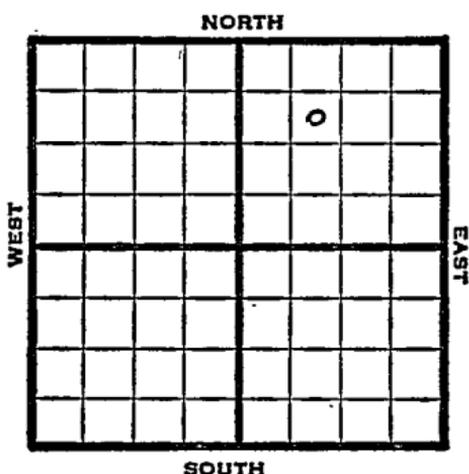

1947

Elev. 1767' REPORT

7/9

R U R

7/16

8" @ 200'  
Drlg. 2731'

7/22

"

7/30

Arb. 3293'  
5" @ 3293'  
Pump 400 Pot  
Gr. 43.0  
TD 3300'

**COMPLETED**

Map No. \_\_\_\_\_ Sec. 35 Twp. 19 R. 11W

Well No. 1 Burmeister "B"

Eldorado Ref. etal. Company

**FIRST REPORT**

Contractor

SE NW NE

**SECTION PLAT**

990 Ft. from N. Line

\_\_\_\_\_ Ft. from S. Line

\_\_\_\_\_ Ft. from E. Line

990 Ft. from W. Line

		o	

Barton County

Location \_\_\_\_\_

Rig up \_\_\_\_\_

Drilling and Remarks:

R U R

**RECORD**

Cased \_\_\_\_\_ in., \_\_\_\_\_ ft.

Sand \_\_\_\_\_

Gas \_\_\_\_\_

Oil \_\_\_\_\_

Total Depth \_\_\_\_\_

**PRODUCTION**

1st 24 hrs. Nat. \_\_\_\_\_

1st 24 hrs. after shot \_\_\_\_\_

Gas \_\_\_\_\_ Cu. Ft.

Dry Hole \_\_\_\_\_

Abandoned \_\_\_\_\_

Date

JUL 9 1947 19

S. J. LEWIS Scout

Map No. 46 <sup>Kansas</sup> Sec. 35 Twp. 19 R. 11W

Well No. 1 Burmeister "B"

Eldorado Ref. et al. Company

**COMPLETE**

Contractor

SE NW NE


*E 11767*  
SECTION PLAT

990 Ft. from N. Line

\_\_\_\_\_ Ft. from S. Line

\_\_\_\_\_ Ft. from E. Line

990 Ft. from W. Line

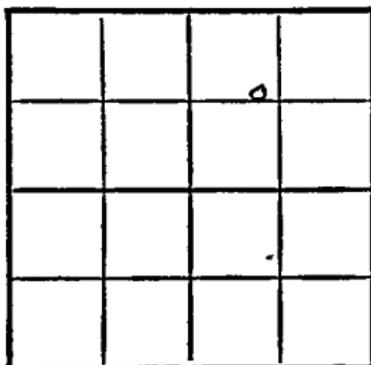

Barton County

**RECORD**

Location \_\_\_\_\_

Cased \_\_\_\_\_ in., \_\_\_\_\_ ft.

Rig up \_\_\_\_\_

Sand \_\_\_\_\_

Drilling and Remarks: \_\_\_\_\_

Gas \_\_\_\_\_

*Art 3293*

Oil \_\_\_\_\_

*5" 3293*

Total Depth 3800

*Pump 400 ft*

**PRODUCTION**

1st 24 hrs. Nat. \_\_\_\_\_

1st 24 hrs. after shot \_\_\_\_\_

Gas \_\_\_\_\_ Cu. Ft.

Dry Hole \_\_\_\_\_

Abandoned \_\_\_\_\_

Date

JUL 30 1947

19

S. J. LEWIS

Scout