



Sec. 35 Twp. 19 R. 11W

Well No. #1 Schmidt Farm

W.W. Garvey et al Company

Silica Pool


Ft. from N. Line

330' Ft. from S. Line

Ft. from E. Line

990' Ft. from W. Line

SE SW SE

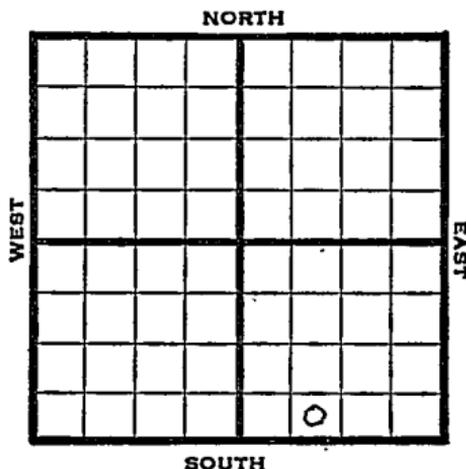

1948

Elev. 1769' REPORT

5/5 8" @ 221'
Anhy. 510'
Drlg. 2265'

5/12 Lansing 3022'
BKC 3280'
Arbuckle 3291'
TD 3296'
5" @ 3293'
RUST

5/19 "

5/26 Arbuckle 3291'
TD 3308'

ABANDONED

Map No. _____ Sec. 35 Twp. 19 R. 11^W

Well No. 1 Schmidt

W. W. Garvey et al. Company

FIRST REPORT Contractor

SE SW SE

SECTION PLAT

_____ Ft. from N. Line

330 _____ Ft. from S. Line

_____ Ft. from E. Line

990 _____ Ft. from W. Line

Barton County

Location _____

Rig up _____

Drilling and Remarks:

8" @ 221

anhy 510

drlg. 2265

RECORD

Cased _____ in., _____ ft.

Sand _____

Gas _____

Oil _____

Total Depth _____

PRODUCTION

1st 24 hrs. Nat. _____

1st 24 hrs. after shot _____

Gas _____ Cu. Ft.

Dry Hole _____

Abandoned _____

Date

MAY 5 1948

19

S. J. LEWIS Scout

