KANSAS

FORM 51 5M 10-41 PETROL


Rice

Section 35 Township 19 Range 10-W

Well No. #3 Miner

Company Phillips

Chase

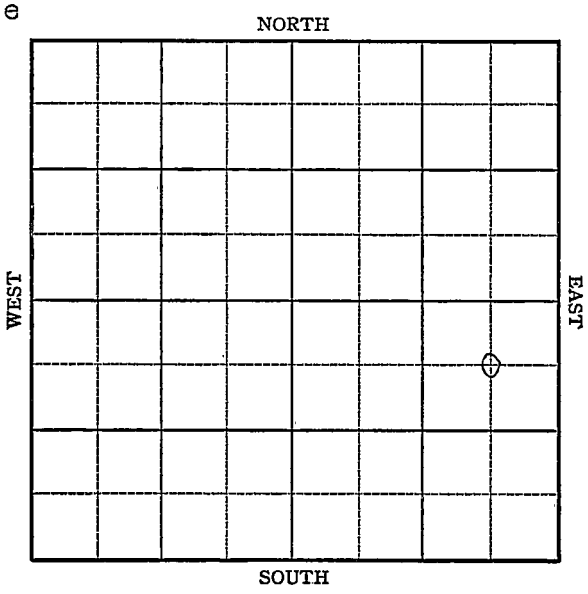

Form 252-A
5M 5-42 Petrol

KANSAS

Rice

Sec. 35 Twp. 19 R. 10-W

Well No. #3 Miner Farm

Phillips Company


Chase pool

660 Ft. from N. Line

Ft. from S. Line

660 Ft. from E. Line

Ft. from W. Line

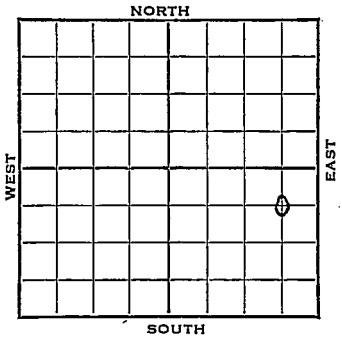

C NE SE. Elev. 1745

1942	REPORT
12/9	Loc.
12/16	8" @ 288 WOC
12/22	Drlg. 3023'
12/29	Arb. 3272 TD 3277 5" - 3273 RUST
1943	
1/6	SO Cement
1/13	T.D. 3281' 500 gal. acid 2800' oil
1/20	Pump 352 oil 44 hrs.
1/27	Arb. 3273 5" @ 3273 T.D. 3281' 500 gal acid Depth Pot. 681 Gravity 44.3

COMPLETED

Form 26 200 Bks 5-42 Petrol

KANSAS

Rice

Map No. 46 Sec. 35 Twp. 19 R. 10W

Well No. 3 Miner

Phillips Company

FIRST REPORT Contractor

C NE SE

660 Ft. from N. Line


_____ Ft. from S. Line

660 Ft. from E. Line

_____ Ft. from W. Line

CHASE POOL

SECTION PLAT

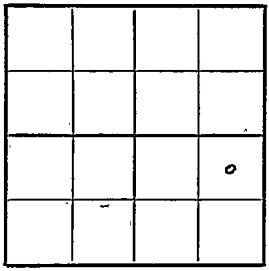

Location XXX

Rig up

Drilling and Remarks:

RECORD

Cased ____ in., ____ ft.

Sand

Gas

Oil

Total Depth

PRODUCTION

1st 24 hrs. Nat.

1st 24 hrs. after shot

Gas ____ Cu. Ft.


Dry Hole

Abandoned

Date

DEC 9 1942 19

S. J. LEWIS Scout

 

Misc. Small Maps	Dma
Cards	Bat.
Tracing	2NB
France Map	✓
Scarborough Map	
Moody Map	
Geological Dept.	
Moody Flat Book	

Form 26 200 Bks 5-42 Petrol Rice

KANSAS

Map No. 4 Sec. 35 Twp. 19 R. 10W

Well No. 3 Miner

Phillips Company

COMPLETED Contractor

C NE SE


660 Ft. from N. Line

Ft. from S. Line

660 Ft. from E. Line

Ft. from W. Line

SECTION PLAT

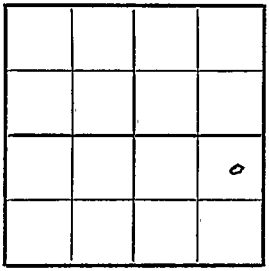

CHASE POOL

Location

Rig up

Drilling and Remarks:

Cr X 3273

5" @ 3273

500 Acid

Jet Th RP X 687

44 3/4 G

RECORD

Cased in., ft.

Sand

Gas

Oil

Total Depth 3281

PRODUCTION

1st 24 hrs. Nat.

1st 24 hrs. after shot

Gas Cu. Ft.


Dry Hole

Abandoned

Date

JAN 27 1943 19

S. J. LEWIS Scout

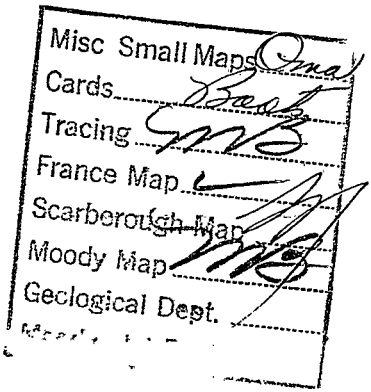
Misc Small Maps
Cards
Tracing
France Map
Scarborough Map
Moody Map
Geological Dept.