


Section 35 Township 19 Range 10-W

Well No. #4 Miner

Company Phillips

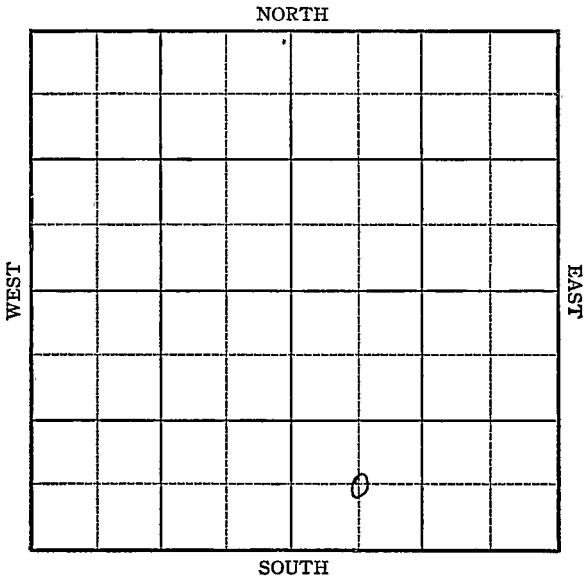

KANSAS

Rice

Sec. 35 Twp. 19 R. 10-W

Well No. #4 Miner Farm

Phillips Company

Chase


 Ft. from N. Line

660 Ft. from S. Line

 Ft. from E. Line

660 Ft. from W. Line

C SW SE Elev. 1746

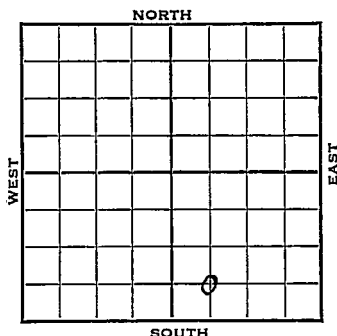

1943

REPORT

1/20 Location.

1/27 Rotary.

2/3 8" @ 289'
Drlg. 2622'

2/10 Lans 2985
Simp. 3276
Arb. 3282-85 TD
5" @ 3282' RUST

2/17 HFO Swab 32 oil $\frac{1}{2}$ hr 2600' prof
Bottom.

2/24 Arb. 3282
5" @ 3282'
T.D. 3285'
300 gal acid
Depth Pot. 6031'
Max. 3000
Gravity 43.7

COMPLETED

KANSAS

Map No. 46 Sec. 35 Twp. 19 R. 10WWell No. 4 MinerPhillips

Company

Contractor

C SW SE

SECTION PLAT

		o	

Ft. from N. Line

660

Ft. from S. Line

Ft. from E. Line

660

Ft. from W. Line

CHASE POOL

Location XXX

Rig up

Drilling and Remarks:

RECORD

Cased _____ in., _____ ft.

Sand _____

Gas _____

Oil _____

Total Depth _____

PRODUCTION

1st 24 hrs. Nat. _____

1st 24 hrs. after shot _____

Gas _____ Cu. Ft.

Dry Hole _____

Abandoned _____


Date

JAN 20 1943

19

S. J. LEWIS

Scout

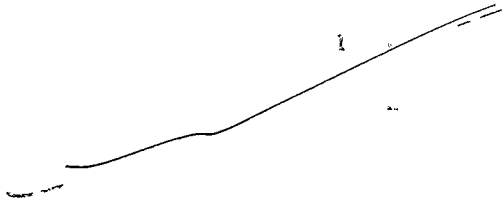

Misc Small Maps	One
Cards	Doat
Tracing	223
France Map	✓
Scarborough Map	✓
Moody Map	✓
Geological Dept.	
Moody Flat Dock	

KANSAS

Map No. 46 Sec. 35 Twp. 19 R. 10WWell No. 4 MinerPhillips

Company

COMPLETED

Contractor

C SW SE

SECTION PLAT

 Ft. from N. Line660 Ft. from S. Line Ft. from E. Line660 Ft. from W. Line

CHASE POOL

Location Rig up

Drilling and Remarks:

*Cor & 3282**5" @ 3282**300 ac. 6**Dep't 1/2 6031**Max 3000**432 Gr*

RECORD

Cased in., ft.Sand Gas Oil Total Depth 3285

PRODUCTION

1st 24 hrs. Nat. 1st 24 hrs. after shot Gas Cu. Ft.Dry Hole Abandoned


Date

FEB 24 1943

19

S. J. LEWIS

Scout

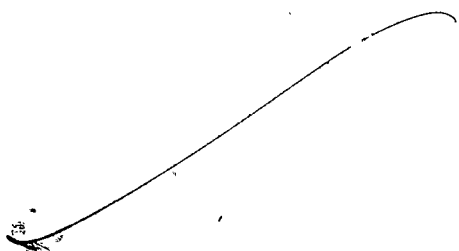

Misc. Small Maps	One
Cards	Books
Tracing	MB
France Map	✓
Scarborough Map	✓
Moody Map	MB
Geological Dept.	
Moody Flat Book	