

KANSAS

Form 51-5M-7-39-Palace


Rice

Section 35 Township 19 Range 10-W

Well No. #1 Wessley

Company Phillips

NORTH Chase Pool

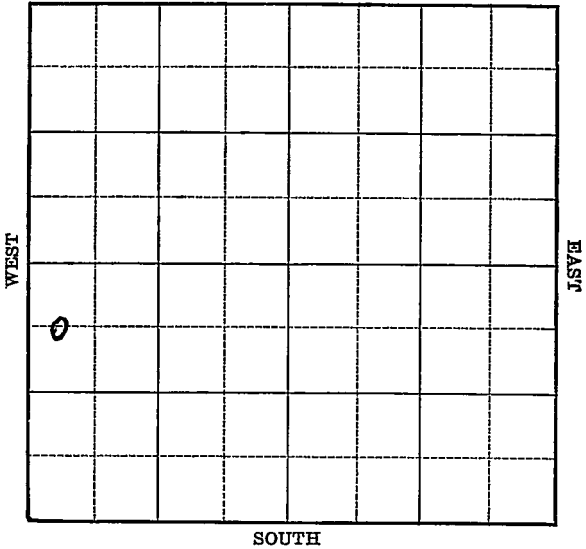


1940	REPORT
2/7	8" - 241' WOG.
2/15	Drlg. 2130'
2/23	Lans. 2984'
	Drlg. 3263'
2/29	Arb. 3303' T.D. 3312'
	5" - 3305' RUST.
3/8	" " "
3/14	1500 acid. C.O.
3/21	500 acid. Pump 88 bbls. 9 hrs.
	Shut down.
3/28	" "
4/3	Arb. 3303'
	5" - 3305'
	T.D. 3312'
	Potential 331 bbls., pump.
	COMPLETED

KANSAS**Rice**Map No. 46 Sec. 35 Twp. 19 R. 10WWell No. 1 WessleyPhillips

Company

Contractor

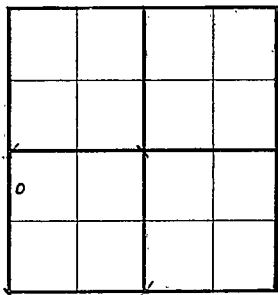FIRST REPORT**C W $\frac{1}{2}$ NW SW**660 Ft. from N. Line Ft. from S. Line Ft. from E. Line330 Ft. from W. Line**SECTION PLAT****CHASE POOL**Location Rig up

Drilling and Remarks:

8" - 241**WOC****RECORD**Cased in., ft.Sand Gas Oil Total Depth **PRODUCTION**1st 24 hrs. Nat. 1st 24 hrs. after shot Gas Cu. Ft.Dry Hole Abandoned

Date

FEB 7 1940 19**S. J. LEWIS** Scout

Map No. 46 Sec. 35 Twp. 19 R. 10WWell No. 1 WessleyPhillips Company

Contractor

COMPLETED

C $W\frac{1}{2}$ NW SW660 Ft. from N. Line

_____ Ft. from S. Line

_____ Ft. from E. Line

330 Ft. from W. Line

SECTION PLAT

o			

CHASE POOL

Location _____

Rig up _____

Drilling and Remarks:

*Ar 83303**5" @ 3305-**Pump 33/100*

RECORD

Cased _____ in., _____ ft.

Sand _____

Gas _____

Oil _____

Total Depth 3312

PRODUCTION

1st 24 hrs. Nat. _____

1st 24 hrs. after shot _____

Gas _____ Cu. Ft.

Dry Hole _____

Abandoned _____

Date

APR 3 1940 19

S. J. LEWIS Scout