

KANSAS

Form 51-5M-7-39-Palace


Rice

Section 35 Township 19 Range 10-W

Well No. #3 Brandenstein

Company Phillips

NORTH Chase Pool

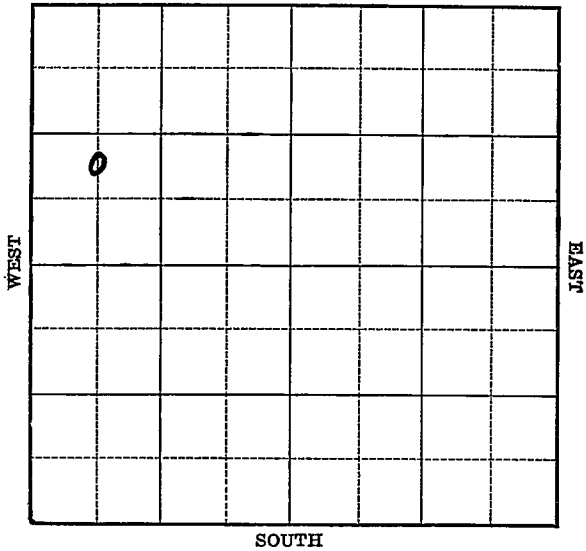

[illegible]

Form 26—200 Bks.—1-40—Palace Rice

Map No. 46 Sec. 35 Twp. 19 R. 10WWell No. 3 BrandensteinPhillips

Company

Contractor

FIRST REPORT

C N L SW NW

 Ft. from N. Line990 Ft. from S. Line Ft. from E. Line660 Ft. from W. Line

CHASE POOL

SECTION PLAT

o			

Location XRig up

Drilling and Remarks:

RECORDCased in., ft.Sand Gas Oil Total Depth **PRODUCTION**1st 24 hrs. Nat. 1st 24 hrs. after shot Gas Cu. Ft.Dry Hole Abandoned

Date

JUN 19 1940

19

S. J. LEWIS Scout

Map No. 46 Sec. 35 Twp. 19 R. 10WWell No. 3 BrandensteinPhillips

Company

Contractor

COMPLETED

SECTION PLAT

C N L SW NW

Ft. from N. Line

990 Ft. from S. Line

Ft. from E. Line

660 Ft. from W. Line

CHASE POOL

◊			

Location

RECORD

Cased _____ in., _____ ft.

Sand _____

Gas _____

Oil _____

Total Depth 3298

Rig up

Drilling and Remarks:

Ar 832915" @ 3291550 andPump 208 BX.

PRODUCTION

1st 24 hrs. Nat. _____

1st 24 hrs. after shot _____

Gas _____ Cu. Ft.

Dry Hole _____

Abandoned _____

Date

JUL 24 1940 19S. J. LEWIS Scout