


Section 35 Township 19 Range 10-WWell No. 1 BrandensteinCompany Phillips Petroleum

NORTH Barngrover Pool

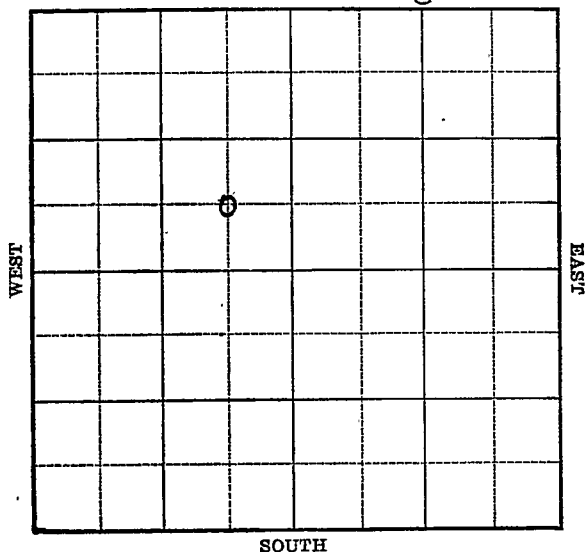

KANSAS


Rice

Sec. 35 Twp. 19 R. 10-WWell No. #1 Brandenstein FarmPhillips Petr. Company

(Barngrover)

 Ft. from N. Line660 Ft. from S. Line660 Ft. from E. Line Ft. from W. Line

Elev. 1755

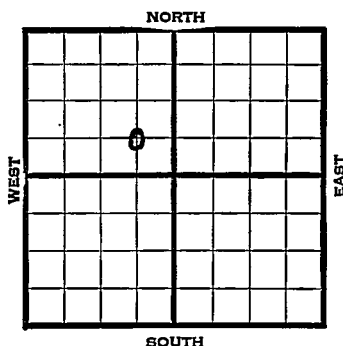

1939	REPORT
5/3	8" - 290'
	Drlg. 1390'
5/12	Topeka 2578' Lans. 2981'
	Drlg. 2990'
5/19	Lans. 2991' (Corrected)
	Sat. 3018-30' Arb. 3302'
	5" - 3302' T.D. 3306' Sat.
	RUST.
5/26	T.D. 3307' 500 acid.
	2300' oil. Swab 55 bbls. 6 hrs.
6/1	1000 acid. Pump 77 oil 7 hrs.
6/7	Arb. 3302 5" 3302
	T.D. 3307
	1500 acid
	Echometer Pot. 312
	COMPLETED

Map No. 46 Sec. 35 Twp. 19 R. 10WWell No. 1 BrandensteinPhillips Petroleum Company

Contractor

FIRST REPORT
C SE NW

SECTION PLAT

	o		

 Ft. from N. Line660 Ft. from S. Line660 Ft. from E. Line Ft. from W. Line

BARNGROVER POOL

Location Rig up

Drilling and Remarks:

8" - 290

Dr lg. 1390

RECORD

Cased in., ft.Sand Gas Oil Total Depth

PRODUCTION

1st 24 hrs. Nat. 1st 24 hrs. after shot Gas Cu. Ft.Dry Hole Abandoned

Date

MAY 3 1939

19

S. J. LEWIS

Scout

KANSAS

Form 26—1M Bks.—2-29

Rice

Map No. 46 Sec. 35 Twp. 19 R. 10WWell No. 1 Brandenstein

Phillips Petroleum

Company

Contractor

COMPLETED

SECTION PLAT

C SE NW

 Ft. from N. Line660 Ft. from S. Line660 Ft. from E. Line Ft. from W. Line

BARNGROVER POOL

	0		

Location

RECORD

Rig up

Cased in., ft.

Drilling and Remarks:

Sand

Gas

Oil

Total Depth 3302

PRODUCTION

1st 24 hrs. Nat. 1st 24 hrs. after shot Gas Cu. Ft.Dry Hole Abandoned

Date

JUN 7 1939

S. J. LEWIS

Scout