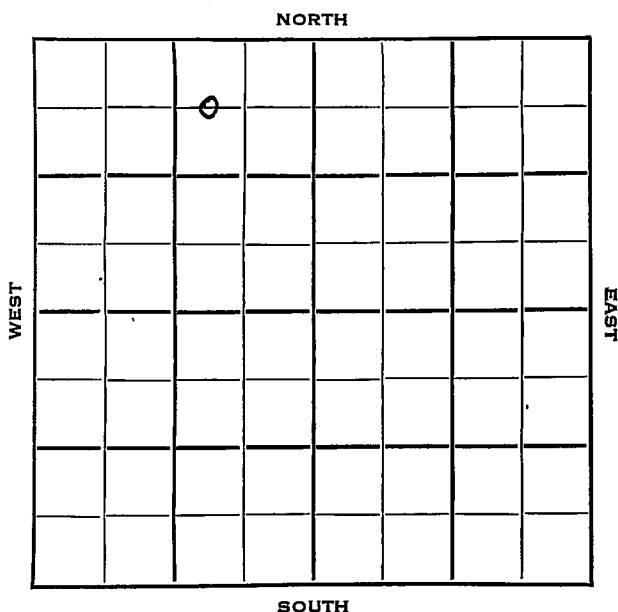


Section 35 Township 19 Range 2WWell No. #1 BishopCompany Bradley & Stickle

Sec. 35 Twp. 19 R. 2WWell No. #1 Bishop FarmBradley & Stickle CompanyStickle Contractor660Ritz-Canyon Pool NORTH
Ft. from N. Line


Ft. from S. Line

990

Ft. from E. Line

Ft. from W. Line

C W L NE NW

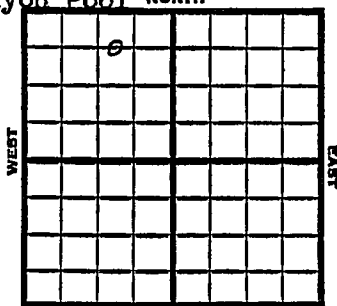

SOUTH

1953

Elev. 1538'

REPORT

7/22

Spud 7-17-53
8" @ 160'

7/29

Drilg. 2354'

8/5

NR

8/12

Miss 2910

RTD 2928

5" @ 2928

DD 2931

8/19

NR

9/9

Spud 7-17-53

Oil Well

TD 2931

8" @ 160

Miss 2910


TD 2928

5" @ 2928

DD 2931, S/1 boph P/18 bopd

Comp. 15 bopd

COMPLETED

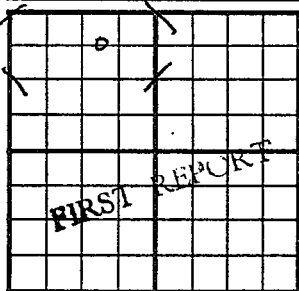
County McPherson State KansasSec. 35 (Blk. Twp.) 19 (Sur. Rge.) 2W Map No.Operator Bradley & StickleWell No. 1 Farm BishopElev. Location C W L NE NW660 Ft. From N Line NW990 Ft. From E Line Quarter1st. Report JUL 22 1953

Completion

Remarks

Stickle - Contr.Spudding Date 7-17-53Drlg. Data Ritz-Canton Pool8" @ 160

County McPherson State Kansas
 Sec. 35 (Blk. 19) (Sur. 2W) (Twp. Map No.)
 Operator Bradley & Stickle
 Well No. 1 Farm Bishop
 Elev. 1538 Location C W L NE NW

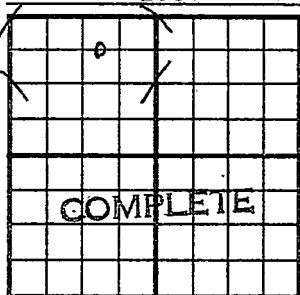

660 Ft. From N Line NW
990 Ft. From E Line Quarter

1st. Report

Completion SEP 9 1953

Remarks Ritz-Canton Pool
Stickle - Contr.

Spudding Date 7-17-53

Drilg. Data Oil well TD 2931
8" @ 160 Miss. 2910 TD 2928
5" @ 2928 DD 2931 S/ 1 boph P/ 18 bopd
Comp. 15 bopd

J. G. McGENEE