

McPherson


Form 51—5M—11-38—Palace

KANSAS

Section 35 Township 19 Range 2-W

Well No. 6 Decker

Company Dickey

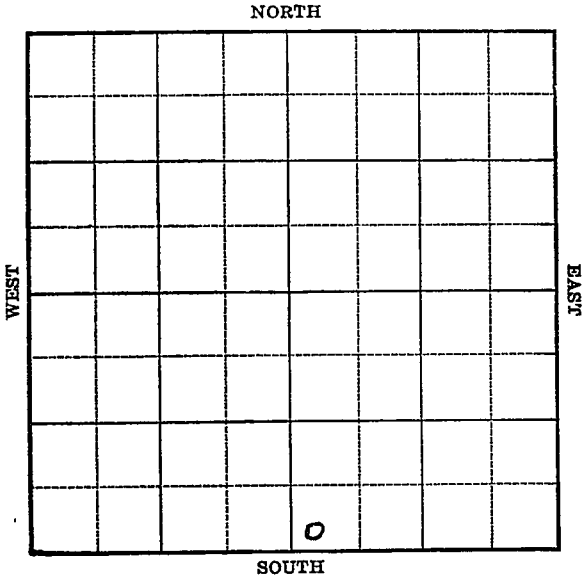


KANSAS

McPherson

Sec. 35 Twp. 19 R. 2-WWell No. #6 Decker FarmDickey

Company

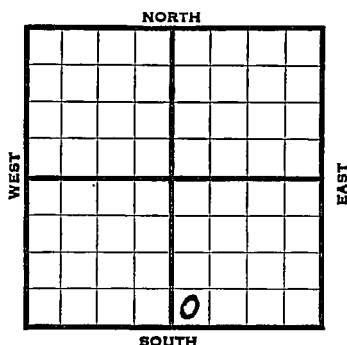 Ft. from N. Line330 Ft. from S. Line Ft. from E. Line330 Ft. from W. Line

Elev. 1538

1938	REPORT
11/16	R U R
11/25	10" - 132'.. Drlg.. 897'.
12/2	Lans. 2308'. Drlg. 2803'.
12/9	Chat. 2919'. 5" - 2920'.
	S. O. & G. 2954'. T. D. 2963'.
	No Inc. S.D.O.
12/15	1000 acid.
12/23	TD 2963' SD.
12/30	" "
1939	
1/6	Pumped 12 oil & 3 water in 24 hrs. S. D. O.
1/11	5" - 2920'..
	Chat. 2919'.
	T. D. 2963'.
	1000 acid.
	Pump 12 oil & 3 water in 24 hrs.
	COMPLETED

Map No. 43 Sec. 35 Twp. 19 R. 2WWell No. 6 DeckerDickey

Company

Contractor

FIRST REPORTSW SE Ft. from N. Line330 Ft. from S. Line Ft. from E. Line330 Ft. from W. Line**SECTION PLAT**

O

Location Rig up

Drilling and Remarks:

RUR**RECORD**Cased in., ft.Sand Gas Oil Total Depth **PRODUCTION**1st 24 hrs. Nat. 1st 24 hrs. after shot Gas Cu. Ft.Dry Hole Abandoned

Date

NOV 16 1938 19H. D. Hatfield

Scout

McPherson

KANSAS

Map No. 43 Sec. 35 Twp. 19 R. 2WWell No. 6 DeckerDickey Company

Contractor

COMPLETED

SECTION PLAT

SW SE

 Ft. from N. Line330 Ft. from S. Line Ft. from E. Line330 Ft. from W. Line

		0	

RITZ CANTON, POOL

Location Rig up

Drilling and Remarks:

*1000 Acid.**Pump 12 oil & 3**IN 24 hrs*

RECORD

Cased 5 in., 2920ft.Sand chat 2919Gas Oil Total Depth 2963

WTR PRODUCTION

1st 24 hrs. Nat. 1st 24 hrs. after shot Gas Cu. Ft.Dry Hole Abandoned

Date

JAN 11 1933

19

D. Hatfield Scout