


KANSAS

M^o (Pherson)

Form 51-5M-11-31-Palace

Map No. 5B Sec. 35 Twp. 19 R. 2 NWell No. 46 Hickory FarmHickory Oil Co Company

NORTH

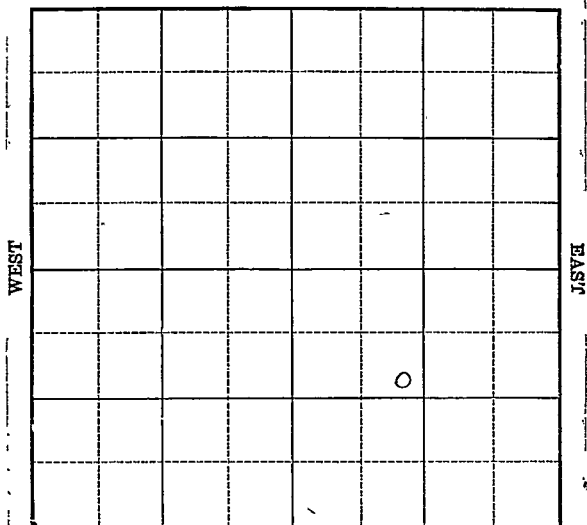

Location _____

Drilling Remarks _____

Rig Up _____

Drilling Remarks _____

RECORD

Cased _____ in. _____ ft.

Sand _____

Gas _____

Oil _____

Total Depth _____

PRODUCTION

1st 24 hrs. Nat. _____

1st 24 hrs. after shot _____

Gas _____ cu. ft.

Dry Hole _____

Abandoned _____

Map No. _____ Sec. 33 Twp. 19 R. 2nd

Well No. ^{5-B}~~4-B~~ *Hucker* Farm


Hickey Oil Co Company

990' Ft. from N. Line

Ft. from S. Line

Ft. from E. Line

990' Ft. from W. Line

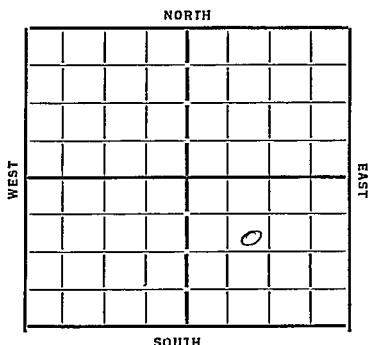

Date 1933

REPORT

3/8	Bldg rig	
3/15	Rigging up	
3/22	20" 49' 15" - 345' - Spud 465'	
3/29	12" - 1290 T.D. 1300	
4/4	2015'	
4/12	10" 2228 d.r.l.g. 2230'	
4/19	8" 2477 " 2830'	
4/26	Top Chat 2938 set 6" log 2961'	
5/4	T.D. 2982 show air N.F.W. - S.D.	
5/10	—	8/19 Top Viola 3386' show air
5/17	—	run 5"
5/24	—	8/17 T.D. 3388 - L.R. 5"
6/1	—	8/23 —
6/8	—	8/30 - L.R. 5" 3150'
6/15	—	9/6 d.r.l.g. 3240
6/21	—	9/13 T.D. 3391 - Run liner
6/28	—	9/20 - T.D. 3406 - Pump 45' below
7/5	—	640' water 12 hrs
7/12	—	9/29 —
7/19	d.r.l.g. 3000	10/5 1000 gal acid testing
7/26	L.R. 6" 3130'	10/11 - Viola 3398 T.D. 3404
8/2	5" - 3130'	1000 gallon acid
		50 oil
		15 water
		COMPLETED

McPherson W
 43 KANSAS
 Map No. *B* Sec. *35* Twp. *19* R. *2*
 Well No. *4* *Decker*
Dickey Oil Co Company
 Contractor

FIRST REPORTS

990 Ft. from N. Line
 _____ Ft. from S. Line
 _____ Ft. from E. Line
990 Ft. from W. Line

SECTION PLAT

Location _____

Rig up _____

Drilling and Remarks:

Blow Rig

RECORD

Cased _____ in., _____ ft.

Sand _____

Gas _____

Oil _____

Total Depth _____

PRODUCTION

1st 24 hrs. Nat. _____

1st 24 hrs. after shot _____

Gas _____ Cu. Ft.

Dry Hole _____

Abandoned _____

Date

MAR 8

1933

CHAS. L. SHERWOOD

192

Scout

McPherson

43 KANSAS Sec. *35* Twp. *19* R. *2*

Well No. *5* *Decker*

Dickey Oil Co Company

Contractor

CORRECTION

990 Ft. from N. Line

Ft. from S. Line

Ft. from E. Line

990 Ft. from W. Line

Correct WELL NUMBER

FROM # *4* to *5*

SECTION PLAT

Location

Rig up

Drilling and Remarks:

Chy Well #

To above.

RECORD

Cased in., ft.

Sand

Gas

Oil

Total Depth

PRODUCTION

1st 24 hrs. Nat.

1st 24 hrs. after shot

Gas Cu. Ft.

Dry Hole

Abandoned

Date

MAR 29 1933

192

CHAS. L. SHERWOOD

Scout

Map No. 43 Sec. 35 Twp. 19 R. 2W

Well No. 5' B' Dicker

Picky oil Company

Contractor

SECTION PLAT

990 Ft. from N. Line

Ft. from S. Line

Ft. from E. Line

990 Ft. from W. Line

COMPLETED

Location

Rig up

Drilling and Remarks:

1000 gal acid

50 oil
15 water

RECORD

Cased in. ft.

Sand Keola 3398

Gas

Oil

Total Depth 3404

PRODUCTION

1st 24 hrs. Nat.

1st 24 hrs. after shot

Gas Cu. Ft.

Dry Hole

Abandoned

Date

10-11-33 192 P. Mannschub Scout