

Map No. KANSAS Sec. 35 Twp. 19 R. 2^w

Well No. 3-Drum Farm
Vernon Oil Company


_____ Ft. from N. Line

330 Ft. from S. Line

_____ Ft. from E. Line

330 Ft. from W. Line

1932

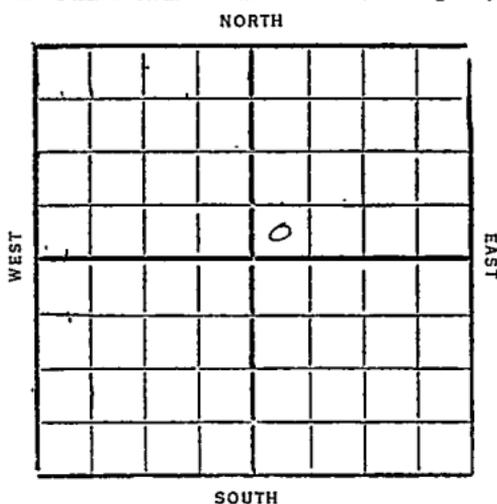

Date REPORT

Date	REPORT
6/15	Bldg rig
6/22	Ran up
6/29	Spdg.
7/6	12 1/2" - 490 Dreg 1220'
7/13	18" - 1617 Dreg 1830'
7/20	" 2295'
7/27	" 2490'
8/3	UIC 6" - 2880'
8/10	Top Chat 2918 6" - 2918 show gas show oil 2931 Increase oil & gas 2948 flow 227 bbl 1 hr
8/17	Cased 6" - 2918 Chat 2918-48 TD 2948 Potential prod 3888 bbl oil Comp.

McPherson

43 KANSAS

W

Map No. Sec. *35* Twp. *19* R. *2*

Well No. *3* *Driem*

Vernon Oil & Gas Co Company

Contractor

FIRST REPORTS

SECTION PLAT

..... Ft. from N. Line

330 Ft. from S. Line

..... Ft. from E. Line

330 Ft. from W. Line

		0	

Location

Rig up

Drilling and Remarks:

Blow Rig

RECORD

Cased *1* in., ft.

Sand

Gas

Oil

Total Depth

PRODUCTION

1st 24 hrs. Nat.

1st 24 hrs. after shot

Gas Cu. Ft.

Dry Hole

Abandoned

Date

JUN 15 1932

CHAS. L. SHERWOOD

192

Scout

McPherson

43 KANSAS Map No. Sec. 35 Twp. 19 R. 2^w

Well No. 3 *Drum*

Vernon Oil & Gas Co Company

Contractor

COMPLETED

SECTION PLAT

.....Ft. from N. Line

330 Ft. from S. Line

.....Ft. from E. Line

330 Ft. from W. Line

Location.....

Rig up.....

Drilling and Remarks:

*Potential prod
3888 Bls.*

RECORD

Cased, 6 in., 2928 ft.

Sand *Char 2918-48*

Gas.....

Oil.....

Total Depth. 2948

PRODUCTION

1st 24 hrs. Nat.....

1st 24 hrs. after shot.....

Gas..... Cu. Ft.

Dry Hole.....

Abandoned.....

Date

AUG 17 1932

192 CHAS. L. SHERWOOD Scout