

Form 51-5M-1-30-38840

Map No. KANSAS Sec. 33 Twp. 19 R. 2

Well No. 1 - R. R. Burn Farm

NORTH

WEST

FAST

.SOUTH

Location _____
Drilling Remarks _____

Rig Up _____
Drilling Remarks

RECORD

Cased_____in. _____ft.

Sand_____

Gas_____

Oil

Total Depth_____

PRODUCTION

1st 24 hrs. Nat. _____

1st 24 hrs. after shot_____

Gas_____cu. ft._____

Dry Hole

Abandoned_____

Map No. KANSAS Sec. 35 Twp. 19 R. 2^w

Well No. 1- Drum Farm
Wm on O'Gand Shell Company


330 Ft. from N. Line

_____ Ft. from S. Line

330 Ft. from E. Line

_____ Ft. from W. Line

1931

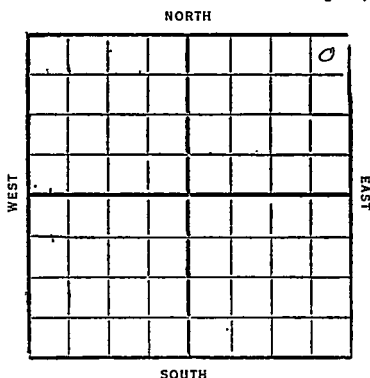

Date

REPORT

2/18	Okd. rig
2/25	Okd.
3/4	Drly 735'
3/11	Run 10"-1560'
3/18	Drly 2235'
3/25	" 2705'
4/1	Top Chat 2920 2916 show gas sitg 5" @sg.
4/8	Top Chat 2916 1/2 ft gas 2919 Oil 2946-66 T.D. 2966 Made 150 bbl oil & 200 bbl water 12 hr May deepen
4/15	TD 2970' swab 185 bbls oil & 80 bbl water 24 hrs
4/22	—
4/29	—

(over)

5/6- Chat 2916-70

T.D. ~~2970~~ 2968' (Corrected)

Made 360 bbl oil
and 70 " water
Comp

1931 OWDD

6/10- Top chat 2916

Old T.D. 2970

Corrected to 2968 SLM.

drilled to

T.D. 2970

(2 ft deeper)

Made 440 bbl 24 hr
some water

6/17- Old T.D. 2968 (corrected)

Top chat 2916

T.D. 2970

Made 440 bbl oil &
15 to 20 bbl water

Comp.

1931 OWDD

9/2- Old T.D. 2970

Rign up

9/9- T.D. 3003' VIR 6"

9/16 —

9/23 —

9/30- T.D. 3003

drdg by 1 jt csq

10/7- T.D. 3003' Esq csq

10/14- Cem at 3003 Clg out

Map No. **KANSAS** Sec. 35 Twp. 19 R. 2^W

Well No. 1- Drum Farm
Vernon Oil & Land Shell Company


NORTH

330 Ft. from N. Line

 Ft. from S. Line

330 Ft. from E. Line

 Ft. from W. Line

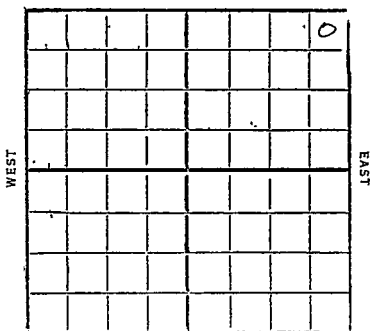

SOUTH

Date

REPORT

10/21	6"-2926 dreg 3087
10/28	Top Viola 3368 Og out
11/4	T.D. 3380 swab 720 bbl 18 hrs
11/10	T.D. 3382 shot 5 qt 3375-82 Og out
11/18	T.D. 3382 Pump 170 bbl 3 hrs
11/24	5"-3368 Viola 3368-82 T.D. 3382 shot 5 qt 3375-82 Potential prod 1535 bbl Comp.

Map No. 43 **KANSAS** Sec. 25 Twp. 19 R. 24

Well No. 1 Trum

Vernon O & G & Shell Company

Contractor


SECTION PLAT

200 Ft. from N. Line

..... Ft. from S. Line

280 Ft. from E. Line

..... Ft. from W. Line

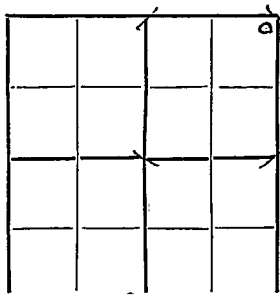

FIRST REPORTS

Location.....

Rig up.....

Drilling and Remarks:

Building rig

RECORD

Cased.....in.,ft.

Sand.....

Gas.....

Oil.....

Total Depth.....

PRODUCTION

1st 24 hrs. Nat.....

1st 24 hrs. after shot.....

Gas.....Cu. Ft.

Dry Hole.....

Abandoned.....

Date

FEB 18 1931

192

S. J. LEWIS

Scout

Small

Returned	
Cards	<i>[Signature]</i>
Tracing	<i>[Signature]</i>
France Map	<i>[Signature]</i>
Scarborough Map	<i>[Signature]</i>
Moody Map	<i>[Signature]</i>
Scarborough Plat Book	
Moody Plat Book	

McPherson

#3 KANSAS

Map No. _____ Sec. 35 Twp. 19 R. 2 W

Well No. 1 Drum

Vernon & Sheel Company

Contractor

COMPLETED

SECTION PLAT

330 Ft. from N. Line

_____ Ft. from S. Line

330 Ft. from E. Line

_____ Ft. from W. Line

			0

Location _____

Rig up _____

Drilling and Remarks:

360 Bls Oil
70 " Water.

RECORD

Cased _____ in., _____ ft.

Sand Chat 2916-2970

Gas _____

Oil _____

Total Depth 2970

PRODUCTION

1st 24 hrs. Nat. _____

1st 24 hrs. after shot _____

Gas _____ Cu. Ft.

Dry Hole _____

Abandoned _____

Date

MAY 7

1931

CHAS. L. SHERWOOD

192 _____ Scout

W. W. Wood
Journal

Returned.....	<i>W. W. Wood</i>
Cards.....	<i>W. W. Wood</i>
Tracing.....	<i>W. W. Wood</i>
France Map.....	<i>W. W. Wood</i>
Scarborough Map.....	<i>W. W. Wood</i>
Moody Map.....	<i>W. W. Wood</i>
Scarborough Plat Book.....	<i>W. W. Wood</i>
Moody Plat Book.....	<i>W. W. Wood</i>

KANSAS

Map No. 43 Sec. 35 Twp. 19 R. 2 ^WWell No. 1 DrumVernon & Sheep Company

Contractor

FIRST REPORTS

330 Ft. from N. Line

Ft. from S. Line

330 Ft. from E. Line

Ft. from W. Line

" " OW DD

SECTION PLAT

			0

Location

T Chat 2916

Rig up

Drilling and Remarks:

Old TD 2970'S. L. M. 2968'Deepened To 2970'440 lbs. in hrs.Some water.

RECORD

Cased _____ in., _____ ft.

Sand _____

Gas _____

Oil _____

Total Depth _____

PRODUCTION

1st 24 hrs. Nat. _____

1st 24 hrs. after shot _____

Gas _____ Cu. Ft.

Dry Hole _____

Abandoned _____


Date

JUN 1 0 1931

CHAS. L. SHERWOOD

192

Scout

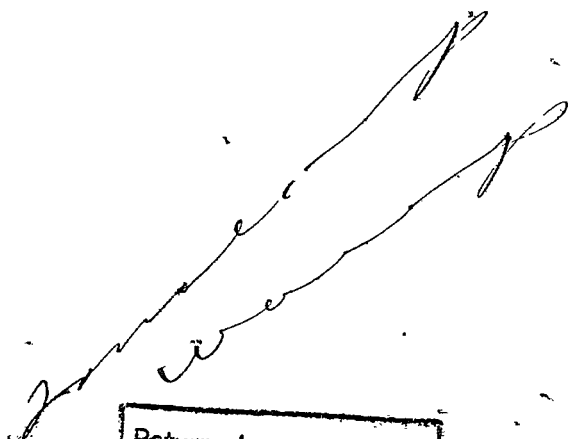

Returned _____
Cards _____
Tracing _____
France Map _____
Scarborough Map _____
Moody Map _____
Scarborough Flat Book _____
Moody Flat Book _____

McPherson

43 KANSAS Map No. Sec. 35 Twp. 19 R. 2 W

Well No. 1 Drum
Vernon & Shell Company

Contractor

COMPLETE

SECTION PLAT

330 Ft. from N. Line

Ft. from S. Line

330 Ft. from E. Line

Ft. from W. Line

"

OW DP

			0

Location

Rig up T Chat 2916

Drilling and Remarks:

440 lbs oil

15 to 20 lbs water

RECORD

Cased in., ft.

Sand

Gas

Oil

Total Depth 2970

PRODUCTION

1st 24 hrs. Nat.

1st 24 hrs. after shot

Gas Cu. Ft.

Dry Hole

Abandoned

Date

JUN 17 1931

CHAS. L. SHERWOOD

192

Scout

Handwritten signatures and scribbles above the form:

Returned	
Cards	<i>[Signature]</i>
Tracing	<i>[Signature]</i>
France Map	<i>[Signature]</i>
Scarborough Map	<i>[Signature]</i>
Moody Map	<i>[Signature]</i>
Scarborough Plat Book	
Moody Plat Book	

Map No. **KANSAS** Sec. **25** Twp. **19** R. **2 W**
43
 Well No. **1** *Drum*

Vernon Oil & Gas & Shell Company

Contractor

FIRST REPORTS

330 Ft. from N. Line

..... Ft. from S. Line

330 Ft. from E. Line

..... Ft. from W. Line

" *OWDD* "

SECTION PLAT

Location.....

Rig up *JD 2970*

Drilling and Remarks:

Rigging up

RECORD

Cased..... in., ft.

Sand.....

Gas.....

Oil.....

Total Depth.....

PRODUCTION

1st 24 hrs. Nat.....

1st 24 hrs. after shot.....

Gas..... Cu. Ft.

Dry Hole.....

Abandoned.....

Date

SEP 2 1931 CHAS. L. SHERWOOD

192..... Scout

*Small Parcel not
returned*

Returned	<i>J.E.</i>
Cards	<i>CS</i>
Tracing	<i>CS</i>
France Map	<i>CS</i>
Scarborough Map	<i>CS</i>
Moody Map	<i>CS</i>
Scarborough Plat Book	
Moody Plat Book	

43 KANSAS.

Map No. _____ Sec. 35 Twp. 19 R. 2

Well No. 1 Drum

Vernon O & G V Shell Company

Contractor

COMPLETED

SECTION PLAT

330 Ft. from N. Line

Ft. from S. Line

330 Ft. from E. Line

Ft. from W. Line

			0
	QW	D	

Location

Rig up

Drilling and Remarks:

5/3375-82

Potential Prod
1535 Bcs.

RECORD

Cased 15' in. 3368 ft.

Sand 3368-82

Gas

Oil

Total Depth 3382

PRODUCTION

1st 24 hrs. Nat.

1st 24 hrs. after shot

Gas Cu. Ft.

Dry Hole

Abandoned

Date

NOV 24 1931

CHAS. L. SHERWOOD

192 Scout

Handwritten signature

Returned	<i>LB</i>
Cards	<i>LB</i>
Tracing	<i>OK</i>
France Map	<i>X</i>
Scarborough Map	<i>LB</i>
Moody Map	<i>LB</i>
Scarborough Plat Book	
Moody Plat Book	