

McPherson

Form 51-5M-2-29-34703

Map No.

KANSAS

Sec.

35

Twp.

19

R.

2W

Well No.


2

Farm

Vernon & Shell

Company

NORTH

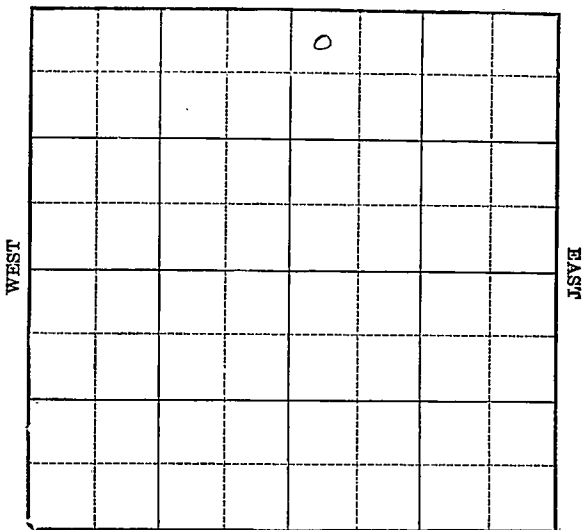

SOUTH

Location

Drilling Remarks

Rig Up

Drilling Remarks

RECORD

Cased _____ in. _____ ft.

Sand _____

Gas _____

Oil _____

Total Depth _____

PRODUCTION

1st 24 hrs. Nat. _____

1st 24 hrs. after shot _____

Gas _____ cu. ft. _____

Dry Hole _____

Abandoned _____

Map No. KANSAS Sec. 35 Twp. 19 R. 2^W

Well No. 2- Drum Farm
Vernon & Shell Company

NORTH


330 Ft. from N. Line

_____ Ft. from S. Line

_____ Ft. from E. Line

330 Ft. from W. Line

1931

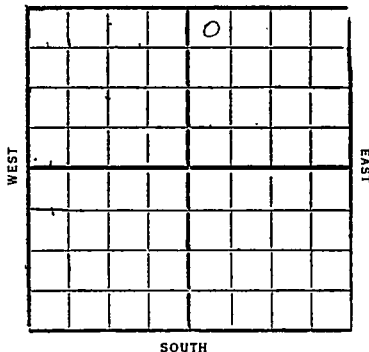

Date

REPORT

12/2	Loc
12/9	—
12/16	—
12/22	—
12/30	—
1932	—
1/6	—
1/13	—
1/20	Clear
1/27	ROS
2/3	—
2/10	—
2/17	—
2/26	Rgn up
3/2	—
3/9	Spdg
3/16	T.D 700'
	Rig burned
	Re-Bldg rig
3/22	Drlg 950
3/30	10" 1601
	Drlg 1955'

4/6- show oil 2255-80

" " 2300
T.D. 2377 UIR 8"

4/13- HFW 2415
8"-2452

4/20- dreg 2533
" 2880

4/27- Top Chat 2905
6"-2905

Get 3 A. gas
T.D. 2935

5/4- flow 240 bbl 12 hrs
T.D. 2958

flow 380 bbl 12 hrs

5/11- Cased 6"-2905

Chat 2905-58

T.D. 2958

Potential prod

760 bbl oil

Comp.

O. W. D. D.

1933

9/27- Drilling Seeper
10/5

10/11- dreg 3097

10/18. 5" at 3115. B. Line 3117

Top Viola 3363 with show

oil - T.D. 3364 - UIR. 5"

10/25- T.D. 3374 - 400' oil in hole

11/1 Treated with 1000 gal acid

11/8 set engine

11/15

11/22- Viola 3363 T.D. 3374

1000 gallon acid

205 bbls

COMPLETED

43 *McPherson*
 Map No. **KANSAS** Sec. *35* Twp. *19* R. *2* ^W

Well No. *2* *Drum*
Vernon & Steel Company

Contractor

FIRST REPORTS

SECTION PLAT

330 Ft. from N. Line

..... Ft. from S. Line

..... Ft. from E. Line

330 Ft. from W. Line

		0	

Location..... ✓

Rig up.....

Drilling and Remarks:*

RECORD

Cased..... in., ft.

Sand.....

Gas.....

Oil.....

Total Depth.....

PRODUCTION

1st 24 hrs. Nat.....

1st 24 hrs. after shot.....

Gas..... Cu. Ft.

Dry Hole.....

Abandoned.....

Date

DEC 2 1931

CHAS. L. SHERWOOD

192

Scout

For use

Returned	
Cards	
Tracing	
France Map	
Scarborough Map	
Moody Map	
Scarborough Plat Book	
Moody Plat Book	

McPherson

43 KANSAS

Map No. Sec. 35 Twp. 19 R. 2

Well No. 2 Drum

Vernon & Sheel Company

Contractor

COMPLETED

SECTION PLAT

		o	

330 Ft. from N. Line

Ft. from S. Line

Ft. from E. Line

330 Ft. from W. Line

Location

Rig up

Drilling and Remarks:

Potential Prod
760 bbls.

RECORD

Cased 6 in., 2905 ft.

Sand Chas 2905-2958

Gas

Oil

Total Depth 2958

PRODUCTION

1st 24 hrs. Nat.

1st 24 hrs. after shot

Gas Cu. Ft.

Dry Hole

Abandoned

Date

MAY 1 1 1932

CHAS. L. SHERWOOD

192

Scout

Returned

Cards

Tracing

France Map

Scarborough Map

Moody Map

Scarborough Plat Book

Moody Plat Book

Johnson
 Map No. 43 Sec. 35 Twp. 19 R. 2W
 Well No. 2-Drum
Vernon O & H Company
 Contractor

SECTION PLAT

330 Ft. from N. Line

..... Ft. from S. Line

..... Ft. from E. Line

330 Ft. from W. Line

FIRST REPORTS

		0	

Location.....

Rig up..... ✓

Drilling and Remarks:

OTU 2958

RECORD

Cased..... in., ft.

Sand.....

Gas.....

Oil.....

Total Depth.....

PRODUCTION

1st 24 hrs. Nat.....

1st 24 hrs. after shot.....

Gas..... Cu. Ft.

Dry Hole.....

Abandoned.....

Date
 SEP 27 1933

P. Mammisch

Returned

Cards

Tracing

France Map

Scarborough Map

Moody Map

Scarborough Flat Book

Moody Flat Book

Map No. 43 Sec. 35 Twp. 19 R. 2W

Well No. 2-Drum

Vernon Oil & Gas Company

Contractor

COMPLETED

330 Ft. from N. Line

..... Ft. from S. Line

..... Ft. from E. Line

330 Ft. from W. Line

SECTION PLAT

		0	

Location.....

Rig up.....

Drilling and Remarks:

1000 gal acid

205 lbs

RECORD

Cased..... in.,..... ft.

Sand 1000 3363

Gas.....

Oil.....

Total Depth 3374

PRODUCTION

1st 24 hrs. Nat.....

1st 24 hrs. after shot.....


Gas..... Cu. Ft.

Dry Hole.....

Abandoned.....

Date

11-22-33 192 O. Mannick Scout

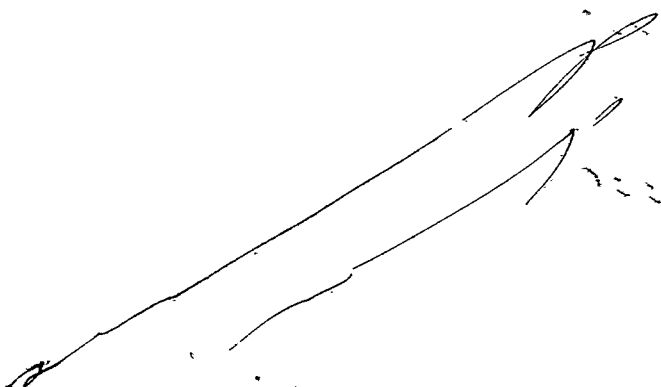

Returned

Cards

Tracing

France Map

Scarborough Map

Moody Map

Scarborough Plat Book

Moody Plat Book