


McPherson

Form 51-5M-2-29-34703

Map No. **KANSAS** Sec. 35 Twp. 19 R. 2nd

Well No. 1- A. G. Dillman Farm
Rosenthal et al Company

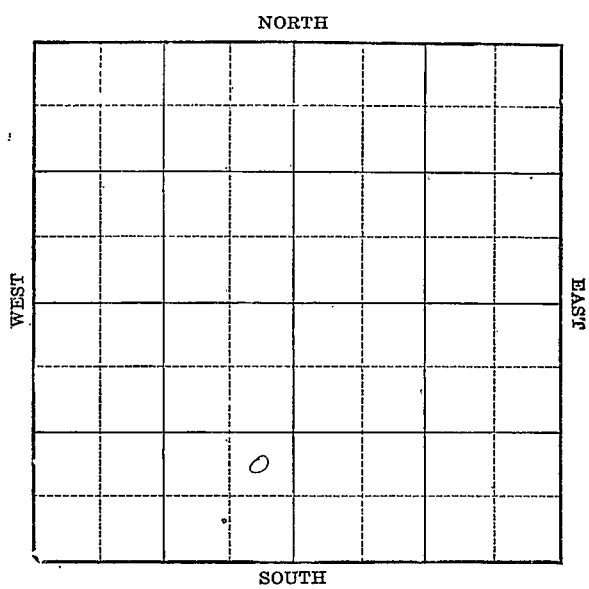

Location _____
Drilling Remarks _____

RECORD

Cased _____ in. _____ ft.
Sand _____
Gas _____
Oil _____
Total Depth _____


Rig Up _____
Drilling Remarks _____

PRODUCTION

1st 24 hrs. Nat. _____
1st 24 hrs. after shot _____
Gas _____ cu. ft. _____
Dry Hole _____
Abandoned _____

Map No. KANSAS Sec. 35 Twp. 19 R. 2nd
Well No. 1-A. J. Dullman Farm
Rosenthal et al Company

NORTH

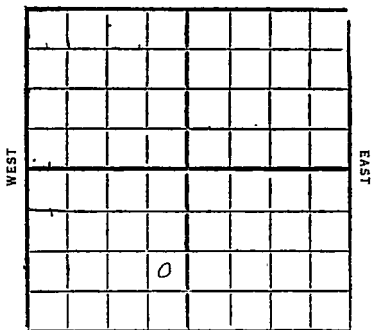

 Ft. from N. Line

990 Ft. from S. Line

330 Ft. from E. Line

1931 Ft. from W. Line

SOUTH

Date

REPORT

6/3	Pos.
6/10	Spdg.
6/17	Drlg 357
6/24	SID 357'
7/1	—
7/8	—
7/15	—
7/22	—
7/29	—
8/5	—
8/12	—
8/19	—
8/26	—
9/2	—
9/9	—
9/16	—
9/23	—
9/30	—
10/7	—
10/14	—
10/21	—
10/28	Drlg 1925'

11/4- SD 2600
11/10- drl g 2840
11/18- Cored Chat 2930-55
show oil

11/24- SD 2955'

12/2- T.D. 2955
Cem 8" - 2932

12/9- TD 2963

mkg small flows

12/16- TD 2963

flow 60 bbl per hr
for 7 hours

12/22- TD 2963

flow 327 bbl 4 hr
shut down

12/30 —

1932

1/6 Chat 2930-63

T.D. 2963

Made 1494 bbl 24 hr
Comp.

KANSAS

McPherson

Map No. _____ Sec. 35 Twp. 19 R. 2 W

Well No. 43 1 a.g. Dillman

Resenthal et al Company

Contractor

FIRST REPORTS

SECTION PLAT

_____ Ft. from N. Line

990 Ft. from S. Line

330 Ft. from E. Line

_____ Ft. from W. Line

Location _____

Rig up _____

Drilling and Remarks:

RECORD

Cased _____ in., _____ ft.

Sand _____

Gas _____

Oil _____

Total Depth _____

PRODUCTION

1st 24 hrs. Nat. _____

1st 24 hrs. after shot _____

Gas _____ Cu. Ft.

Dry Hole _____

Abandoned _____

Date

JUN 3 1931

CHAS. L. SHERWOOD

192

Scout

Returned _____
Cards _____
Tracing _____
France Map _____
Scarborough Map _____
Moody Map _____
Scarborough Plat Book _____
Moody Plat Book _____

43 **KANSAS** Sec. 35 Twp. 19 R. 2^W
 Map No. 1 4 J Dielman
 Well No. Rosenthal & Co Company

Contractor

COMPLETE

SECTION PLAT

Ft. from N. Line

990 Ft. from S. Line

330 Ft. from E. Line

Ft. from W. Line

Location

RECORD

Rig up

Drilling and Remarks:

Cased in, ft.

Sand 2930-2963

Gas

Oil

Total Depth 2963

PRODUCTION

1st 24 hrs. Nat.

1st 24 hrs. after shot

Gas Cu. Ft.

Dry Hole

Abandoned

Date

JAN 6 1932

192 CHAS. L. SHERWOOD

Scout

Sc

Returned	<i>SP</i>
Cards	<i>SP</i>
Tracing	<i>OK</i>
France Map	<i>X</i>
Scarborough Map	<i>SP</i>
Moody Map	<i>X</i>
Scarborough Plat Book	<i>SP</i>
Moody Plat Book	