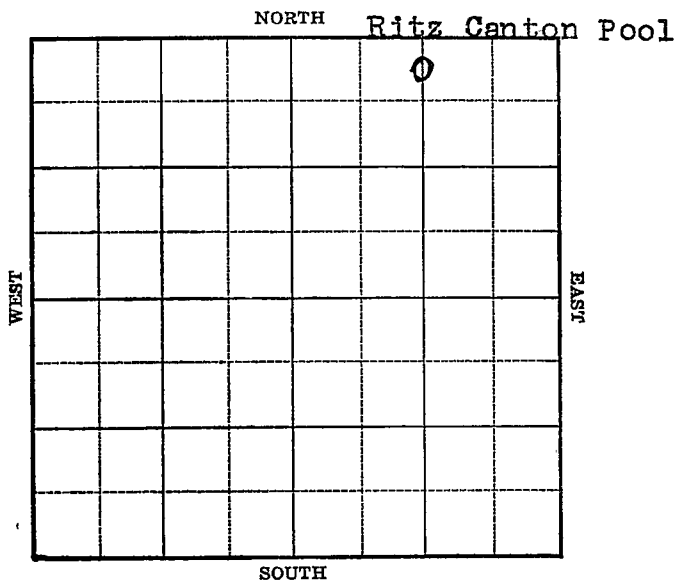
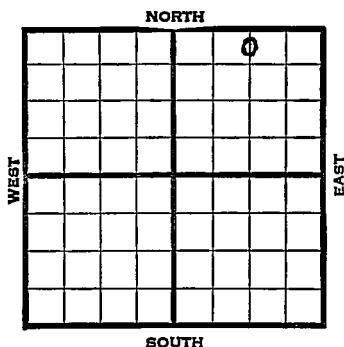


KANSAS

McPherson

Section 35 Township 19 Range 2-WWell No. 7 DrumCompany Nagel & Gussman

Ft. from W. Line

[illegible]

Map No. 43 Sec. 35 Twp. 19 R. 2WWell No. 7 DrumNagel & Gussman

Company

Contractor

FIRST REPORT

C N L NE

SECTION PLAT

			8

330 Ft. from N. Line Ft. from S. Line.1320 Ft. from E. Line Ft. from W. Line

RITZ CANTON POOL

Location Rig up

Drilling and Remarks:

Cable Rig
15" @80

RECORD

Cased in., ft.Sand Gas Oil Total Depth

PRODUCTION

1st 24 hrs. Nat. 1st 24 hrs. after shot Gas Cu. Ft.Dry Hole Abandoned

Date

MAY 17 1939 19

S. J. LEWIS Scout

Map No. 43 Sec. 35 Twp. 19 R. 2WWell No. 7 DrumNagel & Gussman

Company

Contractor

COMPLETED

SECTION PLAT

C N L NE


330 Ft. from N. Line

_____ Ft. from S. Line

1320 Ft. from E. Line

_____ Ft. from W. Line

RITZ CANTON POOL

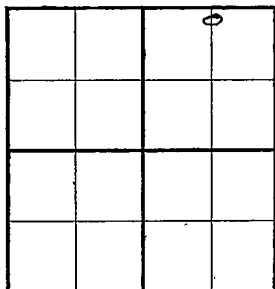

Location _____

Rig up _____

Drilling and Remarks:

*Chas 2930**6" @ 2932**Pump 100 gals per
day. some water*

RECORD

Cased _____ in., _____ ft.

Sand _____

Gas _____

Oil _____

Total Depth 2925

PRODUCTION

1st 24 hrs. Nat. _____

1st 24 hrs. after shot _____

Gas _____ Cu. Ft.

Dry Hole _____

Abandoned _____

Date

MAY 31 1939 19

S. J. LEWIS

Scout