


Section 35 Township 19 Range 2-W

Well No. 6 Drum

Company Gussman et al

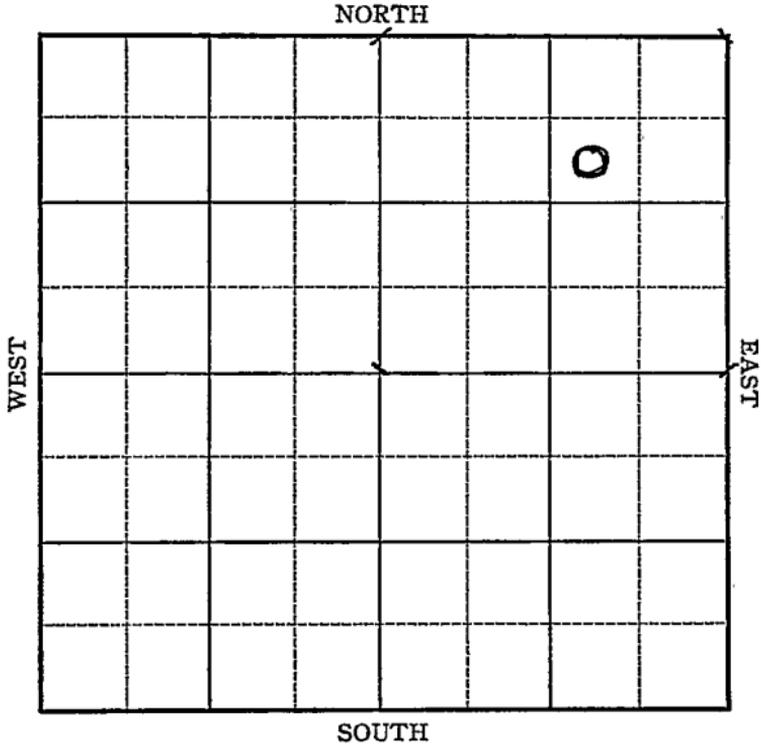

Sec. 35 Twp. 19 R. 2W

Well No. #6 Drum Farm _____

Gussman et al Company _____


990 Ft. from N. Line

_____ Ft. from S. Line

990 Ft. from E. Line

_____ Ft. from W. Line

Elev. 1547

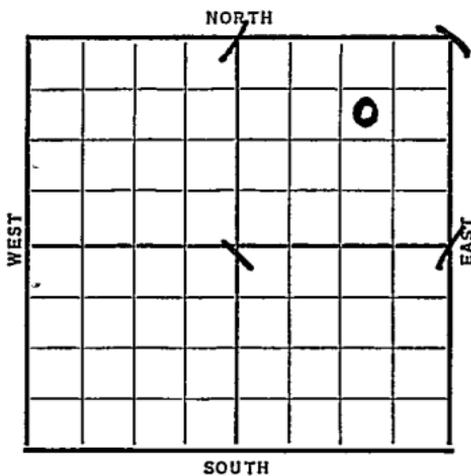

| Date | REPORT |
|-------|-----------------------------|
| 1937 | |
| 8/25 | Material |
| 9/3 | " |
| 9/10 | B.C.R. |
| 9/17 | Rig. |
| 9/24 | R. up. |
| 10/2 | " " |
| 10/8 | Spud. |
| 10/15 | 15" @ 73'. Drlg. 735'. |
| 10/22 | 13" @ 720'. Drlg. 1520'. |
| 10/29 | 10" @ 1625'. Drlg. 1975'. |
| 11/5 | Shut down. |
| 11/12 | K.C. 2285'. 8" @ 2300'. |
| | Drlg. 2481'. No shows. |
| 11/19 | Drlg. 2765'. |
| 11/26 | Chat 2902'. 5" @ 2902' T.D. |
| | S.G. WOC. |
| 12/3 | Chat 2916' (Corrected) |
| | 5" @ 2916'. T.D. 2953'. |
| | 2200' oil. |
| 12/10 | " " |
| 12/17 | " " |

OVER

1937

12/22 5" @ 2916'.

Chat. 2916' (Corrected)

T.D. 2953'.

2000 acid.

Potential 193 bbls.

COMPLETED

M. Pherson

Map No. 43 Sec. 35 Twp. 19 R. 2W

Well No. 6 - Drum

Gussman et al Company

FIRST REPORT Contractor

sw ne ne

990 Ft. from N. Line

_____ Ft. from S. Line

990 Ft. from E. Line

_____ Ft. from W. Line

SECTION PLAT

| | | | |
|--|--|--|---|
| | | | |
| | | | 0 |
| | | | |
| | | | |

Location _____

Rig up _____

Drilling and Remarks:

Mar

RECORD

Cased _____ in., _____ ft.

Sand _____

Gas _____

Oil _____

Total Depth _____

PRODUCTION

1st 24 hrs. Nat. _____

1st 24 hrs. after shot _____

Gas _____ Cu. Ft.

Dry Hole _____

Abandoned _____

Date

AUG 25 1937

19

H. D. Hatfield

Scout

RAY

| | |
|-----------------------|-----|
| Returned | |
| Cards | RAY |
| Tracing | RAY |
| France Map | RAY |
| Scarborough Map | RAY |
| Moody Map | |
| Scarborough Plat Book | |
| Moody Plat Book | |

Map No. 43 Sec. 35 Twp. 19 R. 2WWell No. 6 DrumGussman etal

Company

Contractor

COMPLETED**SECTION PLAT**SW NE NE
990 Ft. from N. Line

_____ Ft. from S. Line

990 Ft. from E. Line

_____ Ft. from W. Line

| | | | |
|--|--|--|---|
| | | | 0 |
| | | | |
| | | | |
| | | | |

Location _____

Rig up _____

Drilling and Remarks:

*zoo acid**POT-192***RECORD**Cased 5 in., 2916 ft.~~Sand~~ *Chat* 2916Gas _____ (*corrected*)

Oil _____

Total Depth 2953**PRODUCTION**

1st 24 hrs. Nat. _____

1st 24 hrs. after shot _____

Gas _____ Cu. Ft.

Dry Hole _____

Abandoned _____

Date

DEC 22 1937 19

H. D. Hatfield
Scout

(1857)

1857

74 18 1857

Handwritten signature



| | |
|-------------------------|-------------------------------|
| Returned | _____ |
| Cards | <i>[Handwritten initials]</i> |
| Tracing | <i>[Handwritten initials]</i> |
| France Map | <i>[Handwritten initials]</i> |
| Sea Borough Map | <i>[Handwritten initials]</i> |
| Moody Map | <i>[Handwritten initials]</i> |
| Moody Plat Book | _____ |