McPherson KANSAS


SECTION 35 TOWNSHIP 19S RANGE 1W

WELL NO. #1 Selzer

COMPANY Messman & Rinehart

NW SE SE

16

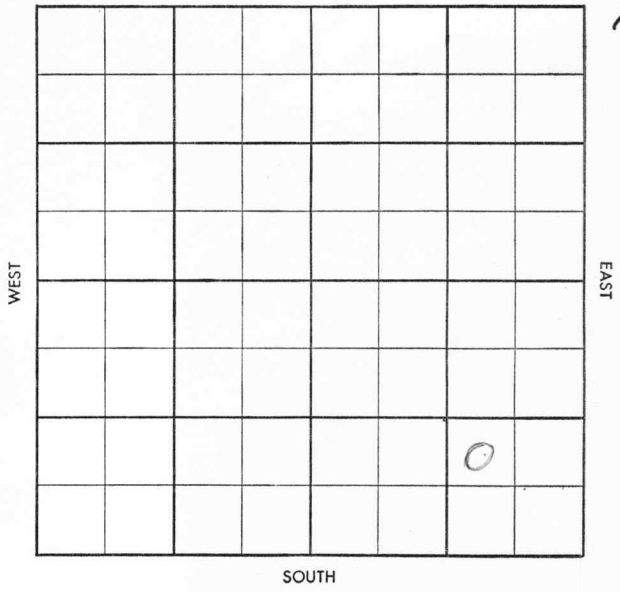

FORM 504-3 SUNRAY

Twp. Pool X

Co. X Facet

WILDCAT

S-513-B

County McPherson Elev. 1563

Sec. 35 Twp. 19 Rge. 1W

Company Messman & Rinehart

Farm Name Selzer No. 1

TOPS	DEPTH	LOG	DATUM
Anh.			
Tp.			
H.			
Tr.			
Dg.			
B. L.			
L.			
K.C.			
B.K.C.			
Ce.			
C.			
M.			
M.			
K.			
Mz.			
Mq.			
V.			
S.			
S.			
A.			
R.			
Pf.			
G.			
T.D.			

Loc. in Sec. NW SE SE

Geol.

Contr. Co. tools

Pool Wildcat



Date Comm. 8-2-58

8" @ 202/130 drlg. 1815

Co. Lse. No. Sec. T. R.

Twp. Pool

Co. Facst. KD

S--513-B

County McPherson Elev. 1565DF

Sec. 35 Twp. 19 Rge. 1W

Company Hessman & Rinehart

Farm Name Selzer No. 1

TOPS	DEPTH	LOG	DATUM
Anh.			
Tp.			
H.			
Tr.			
Dg.			
B.L.			
L.	2313		
K.C.			
B.K.C.			
Ce.			
C.			
M.	2893		
M.			
K.	3105		
Mz.			
Mq.			
V.	3362		
S.			
S.			
A.			
R.			
Pf.			
G.			
T.D.	3368		

Loc. in Sec. NW SE SE

Geol.

Contr. Co. tools

Pool Wildcat



Date Comm. 8-2-58

8" @ 202/130 drlg. 1815 AUG 13 58 DST

2892-2905 1hr 10'M FP 0-15
BHP 510-575 DST 2904-15
1hr G/2½" 183MCF/½ TSTM
/15" 10'gcm FP 35-15 BHP
790-495 DST 3358-64 1hr 56'oil
150'OCSW 840'SW FP 35-460
BHP 900-885 log tops same

D&A