


Section 35 Township 19 Range 11W

Well No. 1 Dorinda Weber

Company Schermerhorn Oil

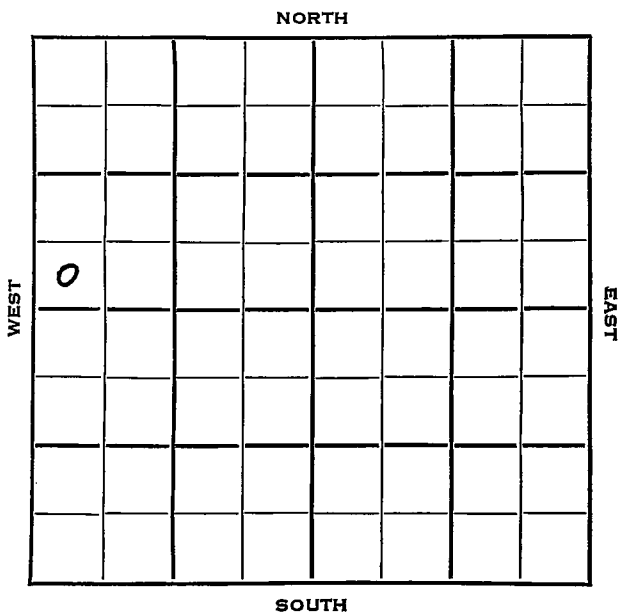

Barton

KANSAS

SEC.	TWP.	R.
35	19	14W ✓

WELL NO.

#1 Dorinda Weber

FARM

COMPANY

Schermerhorn Oil

CONTRACTOR


_____ Ft. from N. Line

330 _____ Ft. from S. Line

_____ Ft. from E. Line

330 _____ Ft. from W. Line

SW SW NW

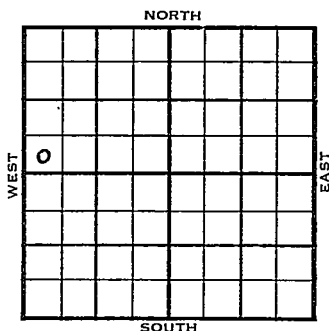

	ELEVATION	REPORT
1954	1878'	

3/24 Location

3/31

D &A

TD 3580'

Anhy 791'

DST 2262'-75' opn $\frac{1}{4}$ hr, rec 12' Mud

Heeb 3115', Br. Lime 3210', Lans

3222'

DST 3212'-47' opn 10 min, rec 8' Mud

Cong 3466'

DST 3359'-80' opn $\frac{1}{2}$ hr, rec 30' Mud

1000#

Arb 3570'

TD 3580'

D &A

ABANDONED

J. G. McGEHEE

County Barton State Kansas
 Sec. 35 (Blk.) 19 (Sur.) 14W Map No.
 Operator Schermerhorn Oil
 Well No. 1 Farm Dorinda Weber
 Elev. 1878 Location SW SW NW

330 Ft. From S Line NW.

330 Ft. From W Line Quarter

1st. Report

Completion MAR 31 1954

Remarks

Spudding Date

Drlg. Data D & A TD 3580

Anhy 791 DST 2262-75 open $\frac{1}{4}$ hr.

Rec. 12' mud Heeb. 3115 Br. lime 3210

Lans. 3222 DST 3212-47 open 10 min.

Rec. 8' mud Cong. 3466 DST 3359-80

open $\frac{1}{2}$ hr. Rec. 30' mud 1000#

Arb. 3570 TD 3580

D & A

J. G. McGEHEE