

Section 35 Township 19 Range 14 W

Well No. # 2 Russell "B"

Company Helmerich & Payne, Inc.

NORTH

					0		

WEST

EAST

SOUTH

Barton

KANSAS

SEC. 35	TWP. 19	R. 14W
---------	---------	--------

WELL NO. 2 Russell "B" FARM

COMPANY Helmerich & Payne, Inc.

CONTRACTOR Wendell Peel


Gt. Bend Airport Pool

990 Ft. from N. Line

Ft. from S. Line

Ft. from E. Line

990 Ft. from W. Line

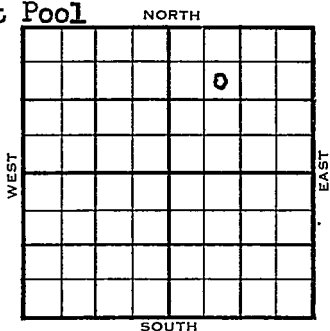

SE NW NE

1953	ELEVATION 1873'	REPORT
------	-----------------	--------

9/9 Location
 9/16 "
 9/23 Anhy 800' 8" @ 805 w/400
 Drlg. 2790'
 9/30 Heeb 3090' Br li 3184' Lans 3194'
 Cong 3432' Arb. 3532
 RTD 3540' 5" @ 3414'
 10/7 N.R.
 10/14 D & A
 10/21 Spud 9-16-53 D & A TD 3540
 Anhy 800 8" @ 805 Heeb 3090
 Br. line 3184 Lans. 3194
 Cong. 3432 Arb. 3532 TD 3540
 5" @ 3414 CO to 3410
 36/3320-26 500 A 1/2 BW tr. oil
 32/3342-47 CO to 3390 11/3382-86
 500 A 15 BW tr. oil. 12/3382-86
 500 A S/2 BFPH 70% wtr. SP 3373
 24/3356-64 B/1 1/2 BFPH 70% wtr.
 SP 3350 15/3342-47 S/8 BWPB 7 hr.
 SP 3330 36/3320-26 B/1 1/2 GWPH
 500 A S/4 1/2 GWPH SP 3230 34/3198-
 3204 500 A 1 BOPB 1000 A
 2000 A S/wtr. CO to 3387 11/3382-
 86' wtr. D & A

ABANDONED

