


Barton

FORM 51

Section 35 Township 19 Range 11W **KANSAS**

Well No. 2 - Weber

Company Honaker etal

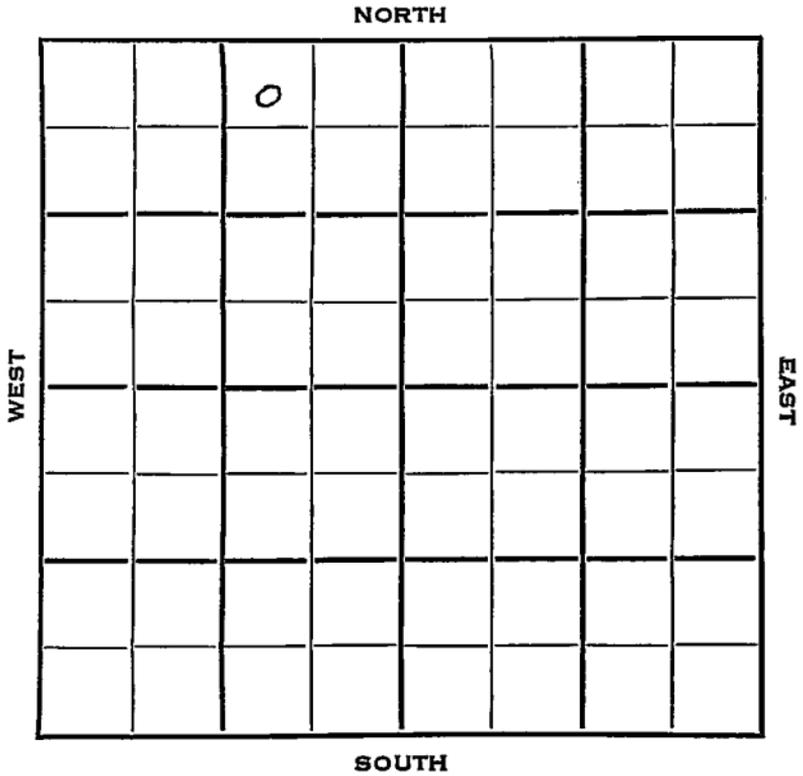

Barton

KANSAS ✓

Sec. 35 Twp. 19 R. 14W

Well No. #2 Weber Farm \_\_\_\_\_

Honaker et al Company \_\_\_\_\_

Contractor \_\_\_\_\_


330 Ft. from N. Line

\_\_\_\_\_ Ft. from S. Line

990 Ft. from E. Line

\_\_\_\_\_ Ft. from W. Line

NW NE NW

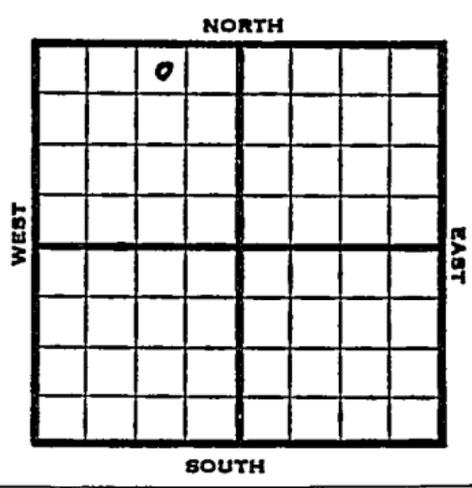

1953 Elev. 1874' REPORT

1/14 Spud 1-12-53  
 1/22 8" @ 799  
 Anhy 794, Heeb 3092, Br Li  
 3185, Lans 3197  
 DST 3199-3219, 1/2 hrs.

1/28 Spud 1-12-53 D & A TD 3395'  
 8" @ 799 Anhy 794 Heeb 3092'  
 Br line 3185' Lans. 3197'  
 DST 3199-3219 open 30 min, rec 10'  
 mud & VSSO 40#  
 DST 3245-70 open 1 hr. rec 270' SOGSW  
 890#  
 DST 3337-95 open 1 hr. rec 445' SW  
 240# TD 3395' D & A

**ABANDONED**



County Barton State Kansas

Sec. 35 (Blk. 19 (Sur. 14W (Twp. 14W Map No.

Operator Honaker et al.

Well No. 2 Farm Weber

Elev. 1874 Location NW NE NW

		0			

330 Ft. From N Line NW

990 Ft. From E Line Quarter

Ist. Report

Completion JAN 28 1953

Remarks

Spudding Date 1-12-53

Drlg. Data D & A TD 3395

8" @ 799 Anhy 794 Heeb. 3092

Br. lime 3185 Lans. 3197 DST 3199-3219

open 30 min. Rec. 10' mud & VSSO 40#

DST 3245-70 open 1 hr. Rec. 270' socsw

890# DST 3337-95 open 1 hr. Rec.

445' sw 240# TD 3395

D & A