


Well No. #1 Koopman

Company W. L. Hartman

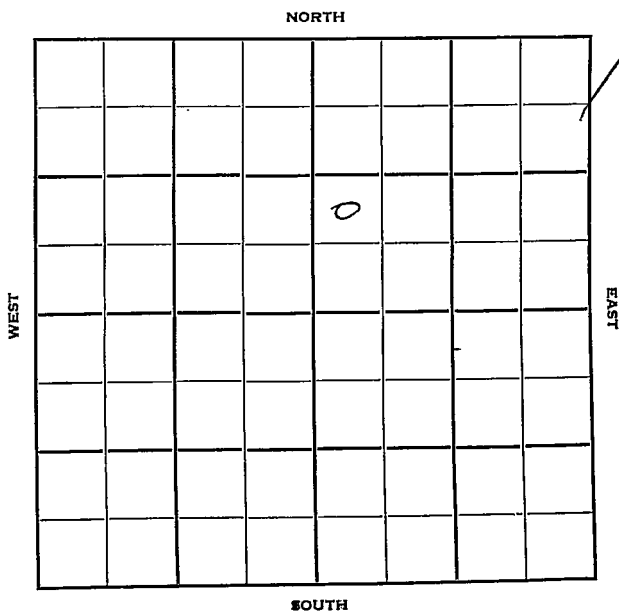

Barton **KANSAS** ✓

Sec. 35 Twp. 19 R. 13W

Well No. #1 Koopman Farm

W. L. Hartman Company

Wildcat Contractor


 Ft. from N. Line

990' Ft. from S. Line

 Ft. from E. Line

330' Ft. from W. Line

NW SW NE

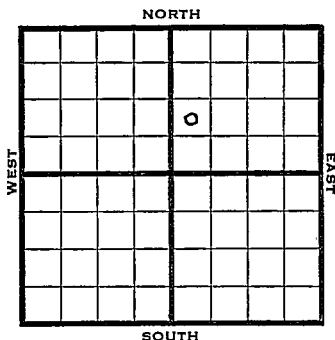

1950

Elev 1839

REPORT

4/26

Location

6/21

TD 3520

8" @ 200

Anhy 690

Topoka 2798

Heeb 3039

Lans 3173

DST 3188-96, opn 1/2 hr rec 70' mud

B KC 3390

Cong 3403

Arb 3435

DST 3436-42 opn 1/2 hr rec 3' mud

DST 3437-50 rec mud

DST 3433-50 opn 1 1/2 hr rec 40' mud

5" @ 3520

121/3450-65

1500 acid

S/240 bw 5 bo 8 hr

sq/perf

40/3437-42

500 acid

39/3442-47

D&A

ABANDONED


Map No. _____ Sec. 35 Twp. 19 R. 13WWell No. 1 Koopman

_____ W. L. Hartman _____ Company

_____ Contractor

NW SW NE

SECTION PLAT

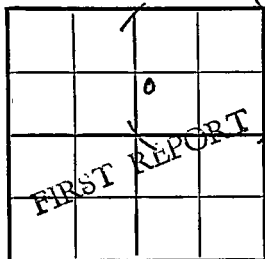

_____ Ft. from N. Line

990 Ft. from S. Line

_____ Ft. from E. Line

330 Ft. from W. Line

Barton County

Location X

Rig up _____

Drilling and Remarks:

RECORD

Cased _____ in., _____ ft.

Sand _____

Gas _____

Oil _____

Total Depth _____

PRODUCTION

1st 24 hrs. Nat. _____

1st 24 hrs. after shot _____

Gas _____ Cu. Ft.

Dry Hole _____

Abandoned _____

Date

APR 26 1950 19J. E. TYRA Scout


Kansas

Map No. _____ Sec. 35 Twp. 19 R. 13WWell No. 1 KoopmanW. I. Hartman

Company

Contractor

NW SW NE

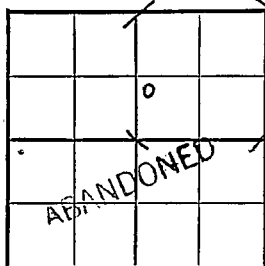El. 1839
SECTION PLAT

Ft. from N. Line

990 Ft. from S. Line

Ft. from E. Line

330 Ft. from W. Line

Barton County

Location _____

Rig up _____

Drilling and Remarks:

8" @ 200

Anhy 690

Topeka 2798

Heeb. 3039

Lans. 3173

DST 3188-96

open 1/2 hr.

Rec: 701 mud

RECORD

Cased _____ in. _____ ft.

Sand _____

Gas _____

Oil _____

Total Depth 3520

PRODUCTION

1st 24 hrs. Nat. _____

1st 24 hrs. after shot _____

Gas _____ Cu. Ft.

Dry Hole _____

Abandoned _____

Date

JUN 21 1950 19J. E. TYRA Scout

B KC 3390

Cong. 3403

Arb. 3435

DST 3435-42

open 1/2 hour

Rec. 3' mud

DST 3437-50

Rec. mud

DST 3433-50

open 1 1/2 hr.

Rec. 40' mud

TD 3520

5" @ 3520

121/ 3450-65

1500 acid

S/- 240 lb. 5 bo. 8 hr.

sq/ perf.

40/ 3437-42

500 acid

39/ 3442-47

Scout Cards A

Land Small Map

Land Wall Map

Tracings

France Map

Pierce Map

Misc.

JUN 9 1950