


Section 35 Township 19 Range 13W

Well No. #1 Becker

Company W. L. Hartman

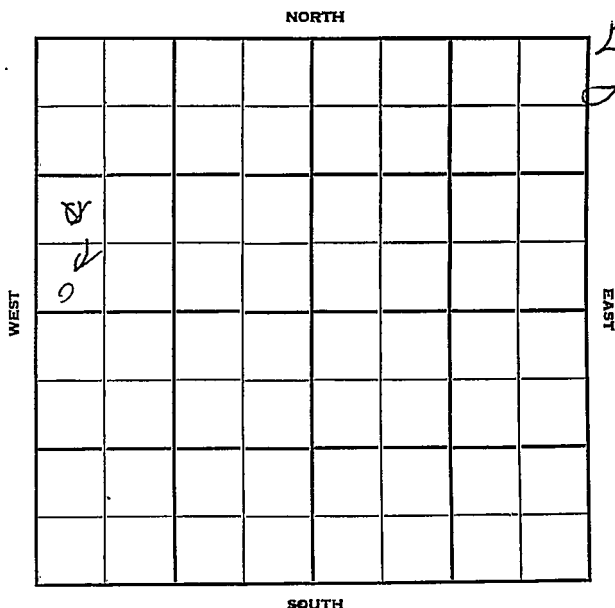

Sec. 35 Twp. 19 R. 13WWell No. #1 Becker FarmW. L. Hartman CompanyW. L. Hartman Contractor

Ft. from N. Line


150  
990

Ft. from S. Line

Ft. from E. Line

150  
330

Ft. from W. Line

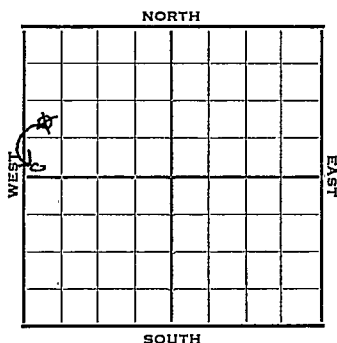SW SW SW NW  
NW SW NW

1952 Elev. 1842' REPORT

6/25 MIR

7/2 NR

7/9 NR

7/17 NR


7/24 "

7/30 8" @ 180'  
Drlg. 2200'8/6 Topeka 2809 Heeb. 3046  
Br Li 3158 KC 3172  
Drlg. 33608/13 Spud 7-27-52  
D&A TD 3500'  
8" @ 180'  
Top. 2809 Heeb. 3046  
Br Li 3158 KC 3172  
Cong. 3418 Arb. 3465  
TD 3500' DST 3466-69 open  $\frac{1}{2}$  hr.  
rec. 20' mud  
DST 3465-69 open  $\frac{1}{2}$  hr. rec. 360'  
gas 20' o & gcm D&A

ABANDONED

**J. G. McGEHEE**

County Barton State Kansas  
 Sec. 35 (Blk.) 19 (Sur.) 13W Map No.  
 (Twp.) (Rge.)  
 Operator W. L. Hartman  
 Well No. 1 Farm Becker  
 Elev. 1842 Location SW SW SW NW

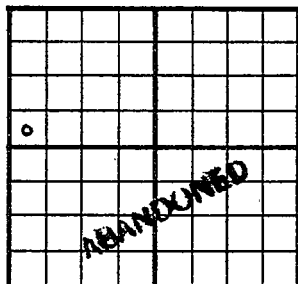

150 Ft. From S Line NW  
150 Ft. From W Line Quarter

1st. Report

Completion AUG 13 1952

Remarks

W.L. Hartman - Contr.

Spudding Date 7-27-52

Drig. Data D & A TD 3500

8" @ 180 Top. 2809 Heeb. 3046

Br. lime 3158 KC 3172 Cong. 3418

Arb. 3465 TD 3500 DST 3466-69

open  $\frac{1}{2}$  hr. Rec. 20' mud DST 3465-69

open  $\frac{1}{2}$  hr. Rec. 360' gas 20' o & gcm

D & A

J. G. McGEHEE

Map No. \_\_\_\_\_ Sec. 35 Twp. 19 R. 13WWell No. 1 Becker

W. L. Hartman

Company

Contractor

SW SW SW NW

## SECTION PLAT

|   |  |  |  |
|---|--|--|--|
|   |  |  |  |
|   |  |  |  |
| 0 |  |  |  |
|   |  |  |  |
|   |  |  |  |

\_\_\_\_\_ Ft. from N. Line

150 Ft. from S. Line

\_\_\_\_\_ Ft. from E. Line

150 Ft. from W. Line

Barton County

Location \_\_\_\_\_

Rig up \_\_\_\_\_

Drilling and Remarks:

Reported

NW SW NW

## RECORD

Cased \_\_\_\_\_ in., \_\_\_\_\_ ft.

Sand \_\_\_\_\_

Gas \_\_\_\_\_

Oil \_\_\_\_\_

Total Depth \_\_\_\_\_

## PRODUCTION

1st 24 hrs. Nat. \_\_\_\_\_

1st 24 hrs. after shot \_\_\_\_\_

Gas \_\_\_\_\_ Cu. Ft.

Dry Hole \_\_\_\_\_

Abandoned \_\_\_\_\_

Date

JUL 30 1952

19

J. G. McGEHEE

Scout