

KANSAS

Form 51-5M-7-39-Palace

Barton

Section 35 Township 19 Range 12-W

Well No. #1 Hammer

Company C. L. Carlock


Wildcat

NORTH

WEST

EAST

SOUTH

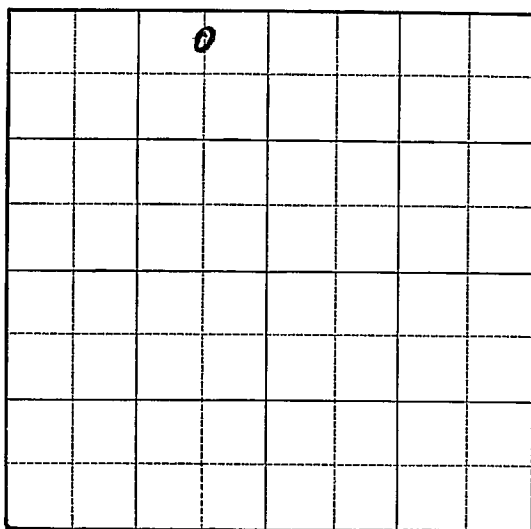

3

KANSAS - Barton

Sec. 35 Twp. 19 R. 12-WWell No. #1 Hammer FarmC. L. Carlock


Company

(Wildcat)

330 Ft. from N. Line330 Ft. from S. Line660 Ft. from E. Line

Ft. from W. Line

Elev. 1804

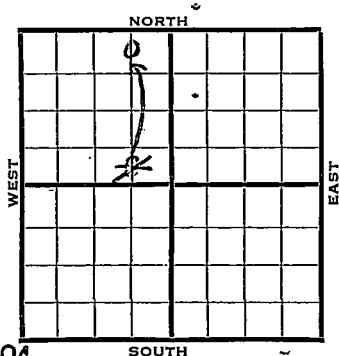

1940	REPORT
5/1	Location
5/9	Rotary.
5/16	"
5/23	"
5/29	"
6/6	"
6/13	"
6/20	"
6/27	"
7/3	"
7/11	10" - 135' Drlg. 1020'
7/18	Topeka 2650' Drlg. 2935'
7/25	Lans. 3105' Arb. 3347½'
	T.D. 3350' 5" - 3347½' RUST.
8/2	500 acid. 1 bbl. oil.
8/8	1000 acid. 2000 acid.
	Swab 8 bbls. per hour.
	41. Gravity
8/14	" "
8/22	" "

OVER

8/28

Arb. 3347 $\frac{1}{2}$

5" 3347 $\frac{1}{2}$

T.D. 3370

4000 acid

Pump 441 Pot.

COMPLETED

Barton

Map No. _____ Sec. 35 Twp. 19 R. 12W

Well No. 1 Hammer

C. L. Carlock

Company

Contractor

FIRST REPORT

C S L SE NW

Ft. from N. Line

330 Ft. from S. Line

660 Ft. from E. Line

Ft. from W. Line

WILDCAT

SECTION PLAT

Location X

Rig up

Drilling and Remarks:

RECORD

Cased _____ in., _____ ft.

Sand

Gas

Oil

Total Depth

PRODUCTION

1st 24 hrs. Nat.

1st 24 hrs. after shot

Gas _____ Cu. Ft.

Dry Hole

Abandoned

Date

MAY 1 1940

19

S. J. LEWIS

Scout

200 Bks.—1-40—Palace Barton **KANSAS**

Map No. 46 Sec. 35 Twp. 19 R. 12W

Well No. 1 Hammer

C. L. Carlock

Company

CORRECTION

Contractor

SECTION PLAT

C N L NE NW

330 Ft. from N. Line

_____ Ft. from S. Line

660 Ft. from E. Line

_____ Ft. from W. Line

WILDCAT

	o		

Location _____

Rig up _____

Drilling and Remarks:

Reported

C S L SE NW

RECORD

Cased _____ in., _____ ft.

Sand _____

Gas _____

Oil _____

Total Depth _____

PRODUCTION

1st 24 hrs. Nat. _____

1st 24 hrs. after shot _____

Gas _____ Cu. Ft.

Dry Hole _____

Abandoned _____

Date

MAY 2 1940 19

S. J. LEWIS

Scout

Map No. 46 Sec. 35 Twp. 19 R. 12W

Well No. 1 Hammer

C. L. Carlock

Company

Contractor

COMPLETED

C N L NE NW

SECTION PLAT

330 Ft. from N. Line

_____ Ft. from S. Line

660 Ft. from E. Line

_____ Ft. from W. Line

WILDGAT

Location _____

Rig up _____

Drilling and Remarks:

Ar & 3347 1/2

5" @ 3347 1/2

4000 @ oil

Pump 441 P.D.

RECORD

Cased _____ in., _____ ft.

Sand _____

Gas _____

Oil _____

Total Depth 3320

PRODUCTION

1st 24 hrs. Nat. _____

1st 24 hrs. after shot _____

Gas _____ Cu. Ft.

Dry Hole _____

Abandoned _____

Date

AUG 28 1940 19

S. J. LEWIS Scout