


Section 35 Township 19 Range 12 W

Well No. # 2 Schulte

Company Hilton Drlg.

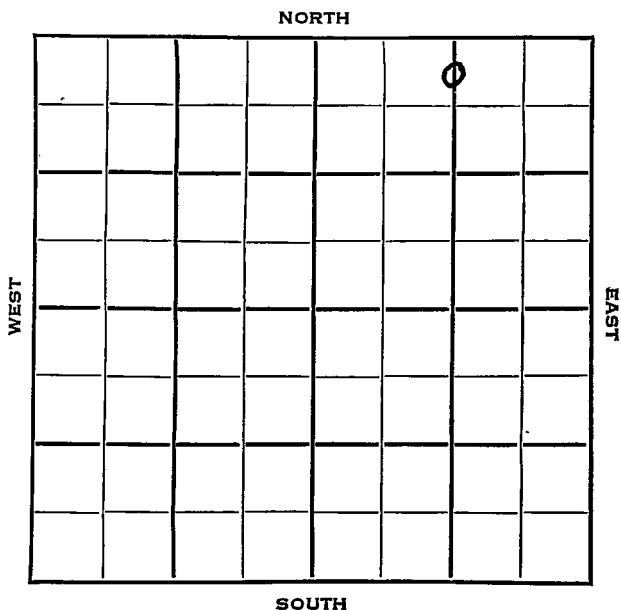

Barton

KANSAS ✓

SEC.	TWP.	R.
35	19	12W

WELL NO.

2 Schulte

FARM

COMPANY

Hilton Drlg.

CONTRACTOR

Hilton Drlg.

Hammer Pool


330 Ft. from N. Line

Ft. from S. Line

1320 Ft. from E. Line

Ft. from W. Line

C N/2 N/2 NE

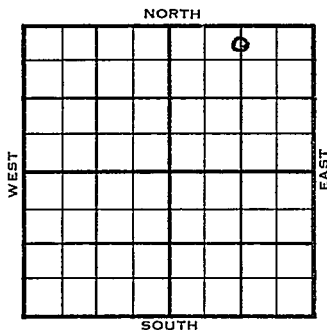

	ELEVATION	REPORT
1953	Elev. 1802'	
9/9	MIR	
9/16	8" @ 179 Anhy 600 Drlg. 2721'	
9/23	Heeb 2966 Br li 3085 Arb. 3361' RTD 3365	KC 3105 4" @ 3363
9/30	DD 3371' 500 A No Help DD 3390 B/ 17 gwph PB 3368	
10/7	Spud 9-9-53 Temp. Abd. TD 3390 8" @ 179 Anhy 600 Heeb 2966 Br lime 3085. KC 3105 Arb. 3361 TD 3365 4" @ 3363 DD 3371 500 A DD 3390 B/17 GWPH PB 3368 Temp. Abd.	
ABANDONED		

