

35

19

12 W


Section \_\_\_\_\_ Township \_\_\_\_\_ Range \_\_\_\_\_

# 1 Schulte

Well No. \_\_\_\_\_

Hilton Drlg.

Company \_\_\_\_\_

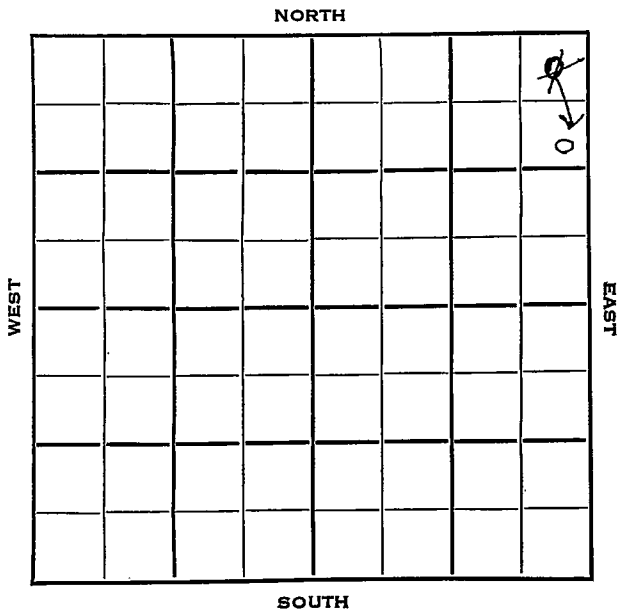

Barton

Sec. 35 Twp. 19 R. 12W

Well No. #1 Schulte Farm

Hilton Drlg. Company

Buick Drlg. Contractor


780  
330 Ft. from N. Line

Ft. from S. Line

150  
330 Ft. from E. Line

Ft. from W. Line

SE  
NE NE NE

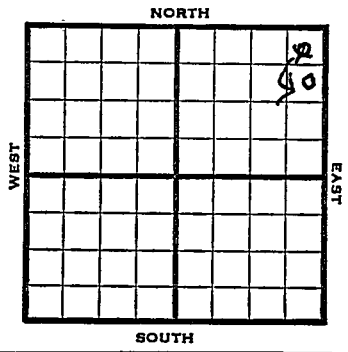

1953 Elev. 1799' REPORT

5/20  
5/28

RUR  
8" @ 170'  
Anhy 585'  
Drlg 2848'

6/3  
6/10

NR  
Spud 5-18-53 Oil well TD 3375  
8" @ 170 Anhy 585 Top 2704  
Br line 3085  
DST 3101-26 open 1/2 hr rec 33' mud  
80# KC 3108  
DST 3185-95 open 40 min rec 10' mud  
960#  
DST 3185-3205 open 1 1/2 hr rec 75' SW  
970# DST 3295-3306 open 35 min rec  
15' mud  
DST 3322-36 open 1/2 hr. rec 15' mud  
DST 2914-30 open 1/2 hr rec 5' mud 1015#  
DST 3366-70 open 35 min rec 3' mud  
50#  
DST 3364-75 open 3/4 hr rec 33' SO &  
GCM 180# TD 3375 5" @ 3365  
CO to 3375 32 GOPH 500 A 2 BOPH  
10 hr.  
Comp. 25 BOPD

COMPLETED



Map No. \_\_\_\_\_ Sec. 35 Twp. 19 R. 12W

Well No. 1 Schulte

Hilton Drlg.

Company

**CORRECTION**

Contractor

SE NE NE

SECTION PLAT

780 Ft. from N. Line

Ft. from S. Line

150 Ft. from E. Line

Ft. from W. Line


Barton County

Location \_\_\_\_\_

Rig up \_\_\_\_\_

Drilling and Remarks:

Reported

NE NE NE

**RECORD**

Cased \_\_\_\_\_ in., \_\_\_\_\_ ft.

Sand \_\_\_\_\_

Gas \_\_\_\_\_

Oil \_\_\_\_\_

Total Depth \_\_\_\_\_

**PRODUCTION**

1st 24 hrs. Nat. \_\_\_\_\_

1st 24 hrs. after shot \_\_\_\_\_

Gas \_\_\_\_\_ Cu. Ft.

Dry Hole \_\_\_\_\_

Abandoned \_\_\_\_\_

Date

MAY 27 1953 19

J. G. McGEHEE

Scout

