


Section 35 Township 19 Range 12W

Well No. #2 Panning

Company Pickrell Drlg.

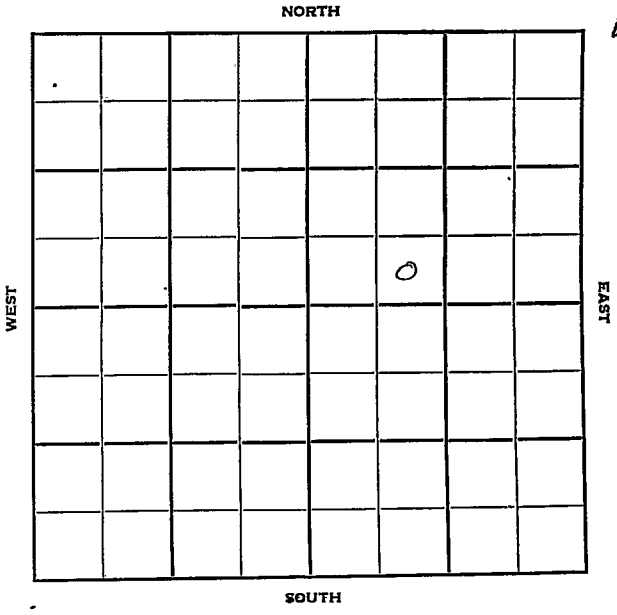

Barton

KANSAS

Sec. 35 Twp. 19 R. 12W

Well No. #2 Panning Farm

Pickrell Drlg. Company

Contractor

Hammer


           Ft. from N. Line

330' Ft. from S. Line

           Ft. from E. Line

990' Ft. from W. Line

SE SW NE

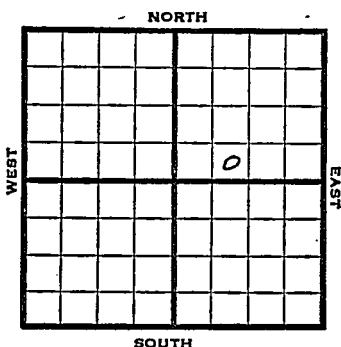

1952

Elev. 1801'

REPORT

1/23

Spud 1-17-52  
8" @ 200  
Drlg. 2886'

2/6

TD 3350 5" @ 3348 POP

2/13

No report

2/20

"

2/27

Spud 1-17-52  
Oil well TD 3357' 8" @ 200  
Heeb 2944' Br. li 3064' Lans. 3085'  
DST 3088-3130 open 50 min. rec 480'  
O & GCM, 180' SW  
DST 3234-50 open 1/2 hr. rec 870' oil  
360' OCM, 180' SW  
Arb. 3347-50 5" @ 3348' TD 3357'  
B/4 BOPH  
Comp. 50 BOPD

COMPLETED



County Barton State Kansas

Sec. 35 (Bik. Twp.) 19 (Sur. Rge.) 12W Map No.

Operator Pickrell Drlg.

Well No. 2 Farm Panning

Elev. 1801 Location SE SW NE


330 Ft. From S Line NE

990 Ft. From W Line Quarter

Ist. Report

Completion FEB 27 1952

Remarks Hammer Pool

Spudding Date 1-17-52

Drlg. Data Oil well TD 3357

8" @ 200 Heeb. 2944 Br. lime 3064

Lans. 3085 DST 3088-3130 open 50 min.

Rec. 480' o & gcm 180' sw DST 3234-50

open 1/2 hr. Rec. 870' oil 360' ocm

180' sw Arb. 3347-50 5" @ 3348

TD 3357 B/ 4 boph Comp. 50 bopd

J. G. McGEHEE