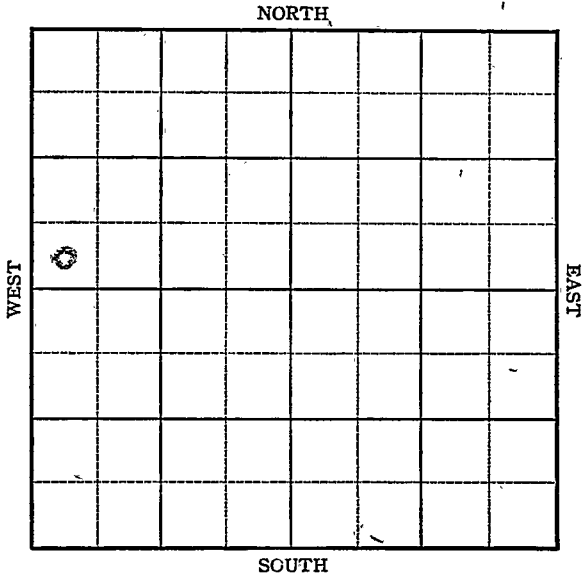
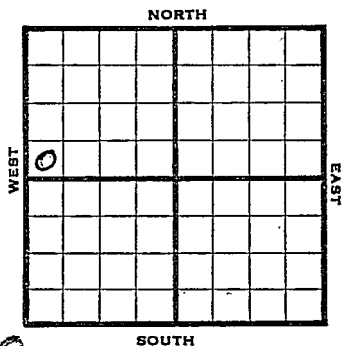


Section 35 Township 19 Range 12WWell No. #2 PanningCompany W.L. Hartman

Sec. 35 Twp. 19 R. 12WWell No. #2 Panning FarmW.L. Hartman Company
Hammer Ft. from N. Line330 Ft. from S. Line Ft. from E. Line330 Ft. from W. LineSW NW Elev. 1809

1945

R E P O R T

2/21	Location
2/28	Spud
3/7	Drlg 1405
3/14	8" @ 141
	Lans 3104
	Drlg 3348
3/23	Cong 3357
	Arb 3365-67 $\frac{1}{2}$
	TD 3367 $\frac{1}{2}$ SO
	5" @ 3366 RUST
3/29	1500 acid.
	250' fluid
4/5	" " "
4/12	1570' oil. 24 hrs.
4/20	" " " "
4/27	" " " "
5/9	Arb 3360
	5" @ 3361
	TD 3366 $\frac{1}{2}$
	1500 acid.
	Pump 26 Pot.
	Grav. 36.7

COMPLETED

Pool Name HammerMap No. 46 Sec. 35 Twp. 19 R. 12WWell No. 2 PanningW. L. Hartman CompanyFIRST REPORT Contractor

SW NW

SECTION PLAT

⊙			

 Ft. from N. Line330 Ft. from S. Line Ft. from E. Line330 Ft. from W. LineBartonLocation XRig up

Drilling and Remarks:

RECORD

Cased in., ft.Sand Gas Oil Total Depth

PRODUCTION

1st 24 hrs. Nat. 1st 24 hrs. after shot Gas Cu. Ft.Dry Hole Abandoned

Date

FEB 21 1945 19S. J. LEWIS Scout


Kansas Pool Name HammerMap No. K-46 Sec. 35 Twp. 19 R. 12WWell No. 2 PanningW.L. Hartman

Company

COMPLETED

Contractor

SW NW

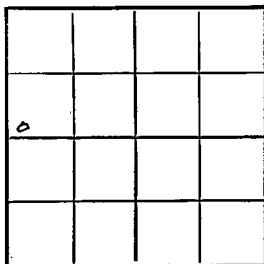E1809
SECTION PLAT Ft. from N. Line330 Ft. from S. Line Ft. from E. Line330 Ft. from W. LineBarton CountyLocation Rig up

Drilling and Remarks:

Cr 433605' @ 33611000 acid/cPump 26 ft36 2/3

RECORD

Cased in., ft.Sand Gas Oil Total Depth 3366 1/2

PRODUCTION

1st 24 hrs. Nat. 1st 24 hrs. after shot Gas Cu. Ft.Dry Hole Abandoned

Date

MAY 9 194519S. J. LEWIS

Scout