FORM 51 25M 8-50 WESTERN


Barton

KANSAS

Section 35 Township 19 Range 12 W

Well No. # 4 Panning

Company Pickerall

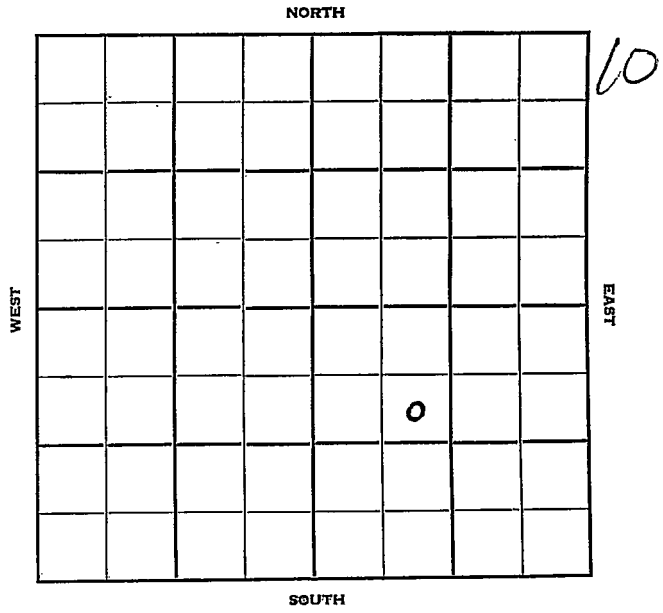

FORM 252-B
10M 8-51 TPCO.

Barton KANSAS

Sec. 35 Twp. 19 R. 12 W

Well No. # 4 Panning Farm

Pickerall Company

Pickerall Contractor


990 Ft. from N. Line

Ft. from S. Line

Ft. from E. Line

990 Ft. from W. Line

SE NW SE

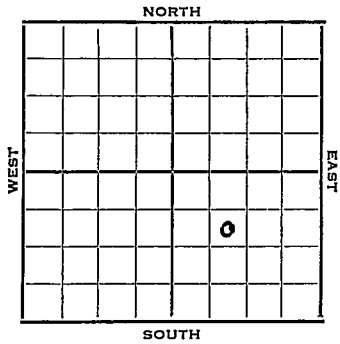

1952	Elev. 1801' REPORT
4/9	Spud 4-5-52 8" @ 174' Anyy 635' Drlg. 1600'
4/23	Heeb. 2949 Br Li 3068 Lans. 3085 DST 2920-44 1 hr 120' O&GCM 990# DST 3122-53 1/2 hr. 190' HGCM 750# IST 3155-65 3/4 hr. 1620' oil 1225# DST 3223-49 1/2 hr. 180 O&GCM 150' O&GCSW Arb. 3342 RTD 3347 5" @ 3345
4/30	NR
5/7	Oil Well TD 3360 8" @ 174 Anhy 635 Heeb. 2949 Br Lime 3068 Lans. 3085 DST 2920-44 opn 1 hr. Rec. 120' o&gcm DST 3122-53 opn ½ hr. Rec. 190' o & gcm DST 3155-65 opn 3/4 hr. Rec. 1620' oil DST 3233-49 opn ½ hr. Rec. 180' o & gcm 150' o & gcsw Arb. 3342 TD 3347 5" @ 3345 DD 3360 S/2 boph 8 hr. Comp. 50 bopd COMPLETED

FORM 275 FOR SALE BY KANSAS BLUE PRINT CO.


County Barton State Kansas

Sec. 35 (Blk. Twp.) 19 (Sur. Rge.) 12W Map No.

Operator Pickerall

Well No. 4 Farm Panning

Elev. Location SE NW SE

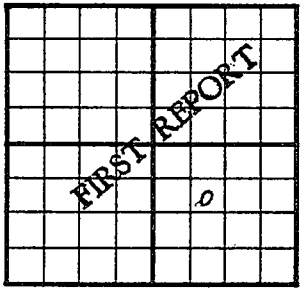

990 Ft. From N Line SE

990 Ft. From W Line Quarter

1st. Report APR 9 1952

Completion

Remarks

Pickerall - Contr.

Spudding Date 4-5-52

Drlg. Data

8" @ 174 Anhy 635 Drlg. 1600

J. G. McGinnis

FORM 275 FOR SALE BY KANSAS BLUE PRINT CO.


County Barton State Kansas

Sec. 35 (Blk. Twp.) 19 (Sur. Rge.) 12W Map No.

Operator Pickrell Drlg.

Well No. 4 Farm Panning

Elev. 1801 Location SE NW SE

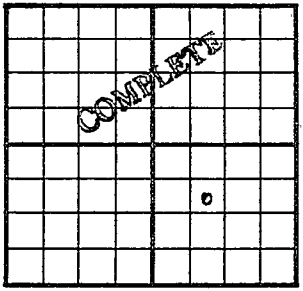

990 Ft. From N Line SE

990 Ft. From W Line Quarter

1st. Report

Completion MAY 7 1952

Remarks

Pickrell Drlg. - Contr.

Spudding Date 4-5-52

Drlg. Data Oil well TD 3360

8" @ 174 Anhy 635 Heeb. 2949

Br. lime 3068 Lans. 3085 DST 2920-44

open 1 hr. Rec. 120' o & gcm DST 3122-53

open ½ hr. Rec. 190' o & gcm DST 3155-65

open 3/4 hr. Rec. 1620' oil DST 3233-49

open ½ hr. Rec. 180' o & gcm 150' o & gc

sw Arb. 3342 TD ~~3347~~ 5" @ 3345

DD 3360 S/ 2 boph 8 hr.

Comp. 50 bopd

J. G. McGEHEE