


Section 35 Township 19 Range 12-W

Well No. #4 Panning

Company W. L. Hartman

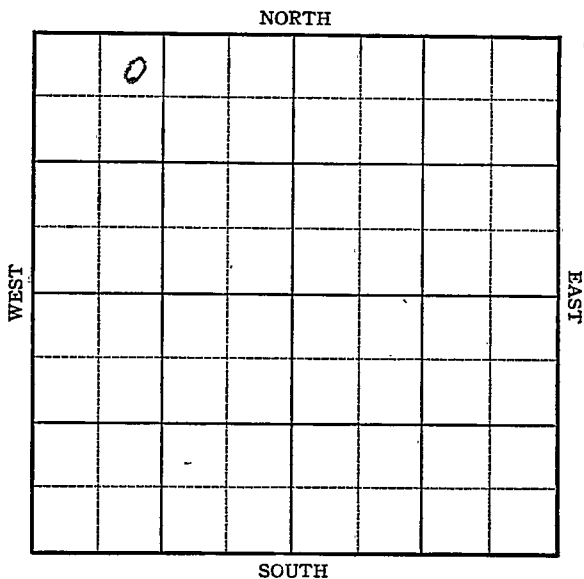

Sec. 35 Twp. 19 R. 12W

Well No. #4 Panning Farm

W. L. Hartman Company

Hammer


330 Ft. from N. Line

\_\_\_\_\_ Ft. from S. Line

\_\_\_\_\_ Ft. from E. Line

990 Ft. from W. Line

NE NW NW

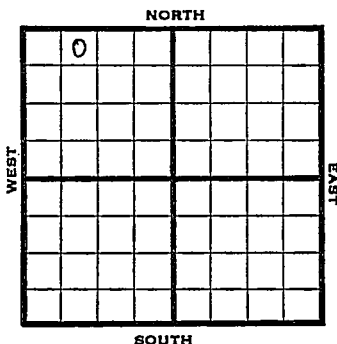

1946 Elev. 1805' REPORT

1/9 Location  
1/17 7 8" - 205' Anhy 590'  
Drlg. 2565'  
1/24 Lans. 3104' BKC 3337'  
Arb. 3357-59' T.D. S.O.  
5" - 3358' RUST.  
1/31 " " "  
2/7 150' oil 12 hours.  
200 acid.  
2/14 " "  
2/21 " "  
2/28 " "  
3/7 " "  
3/14 " "  
  
3/20 Arb. 3357  
5" @ 3358  
200 acid.  
TD 3359  
Pump 25 Pot.  
Grav. 41.0

COMPLETED

Kansas Pool Name Hammer  
 KANSAS ~~76~~ Sec. 35 Twp. 19 R. 12W.  
 Map No. 76

Well No. 4 Panning

W. L. Hartman Company

FIRST REPORT Contractor

NE NW NW

SECTION PLAT

0			

330 Ft. from N. Line

         Ft. from S. Line

         Ft. from E. Line

990 Ft. from W. Line

Barton County

Location          X

Rig up         

Drilling and Remarks:

RECORD

Cased          in.,          ft.

Sand         

Gas         

Oil         

Total Depth         

PRODUCTION

1st 24 hrs. Nat.         

1st 24 hrs. after shot         

Gas          Cu. Ft.

Dry Hole         

Abandoned         

Date

JAN 9 1946 19

S. J. LEWIS Scout

KANSAS Kansas Pool Name Hammer

Map No. 76 Sec. 35 Twp. 19 R. 12<sup>W</sup>

Well No. 4 Panning

W. L. Hartman Company

**COMPLETED**

Contractor

NE NW NW

*E. 1965*

**SECTION PLAT**

330 Ft. from N. Line

\_\_\_\_\_ Ft. from S. Line

\_\_\_\_\_ Ft. from E. Line

990 Ft. from W. Line

0			

Barton County

Location \_\_\_\_\_

Rig up \_\_\_\_\_

Drilling and Remarks:

*Cor 3357*  
*5" Cor 3357*  
*250000*  
*Pump 25000*  
*H. J. Lewis*

**RECORD**

Cased \_\_\_\_\_ in., \_\_\_\_\_ ft.  
 Sand \_\_\_\_\_  
 Gas \_\_\_\_\_  
 Oil \_\_\_\_\_  
 Total Depth 2357

**PRODUCTION**

1st 24 hrs. Nat. \_\_\_\_\_  
 1st 24 hrs. after shot \_\_\_\_\_  
 Gas \_\_\_\_\_ Cu. Ft.  
 Dry Hole \_\_\_\_\_  
 Abandoned \_\_\_\_\_

Date

MAR 20 1946

19

**S. J. LEWIS**

Scout