

FORM 51


Barton

KANSAS

Section 35 Township 19 Range 12W

Well No. #5 Hammer "A"

Company W. L. Hartman

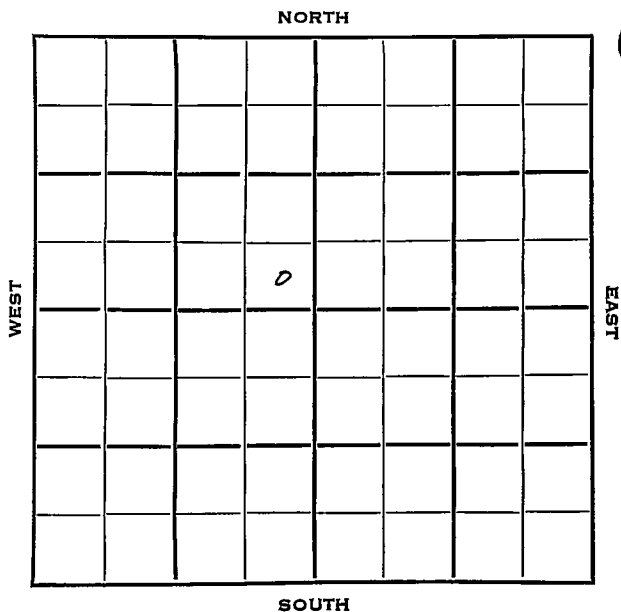

Barton

Sec. 35 Twp. 19 R. 12W

Well No. #5 Hammer "A" Farm

W. L. Hartman Company

Hartman Contractor


Hammer Pool

Ft. from N. Line

NORTH

330 Ft. from S. Line

330 Ft. from E. Line

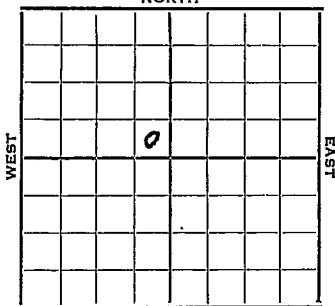

Ft. from W. Line

SE SE NW

SOUTH

1953 Elev. 1804' REPORT

2/18 Spud 2-11-53
8" @ 173
Drlg. 2744

2/26 Drlg. 3200

3/12 Top 2708 Heeb 2950 Br li 3067
Lans 3082 B KC 3326 Arb. 3335 1/2'
RTD 3338 5" @ 3338

3/19 NR

3/26 POP

4/2 "

4/9 "

4/16 NR

4/23 "

4/30 "

5/7 "

5/21 "

5/28 "

6/3 NR

6/10

Spud 2-11-53 Oil well TD 3340
8" @ 173 Top 2708 Heeb 2950
Br lime 3067 Lans 3082 B KC 3326
Arb. 3335 TD 3338 5" @ 3338
DD 3340
Comp. 25 BOPD

COMPLETED

