

KANSAS

Barton

Section 35 Township 19 Range 12W

Well No. #5 ~~Tanner~~ Panning

Company W. L. Hartman

Hammer Pool

NORTH

WEST

EAST

0							

SOUTH

12

KANSAS

Barton

✓

Sec. 35 KANSAS Twp. 19 R. 12W

Well No. #5 ~~Tanner~~ *Panning* Farm
W. L. Hartman Company

Hammer Pool


330' Ft. from N. Line

Ft. from S. Line

Ft. from E. Line

330' Ft. from W. Line

NW SW

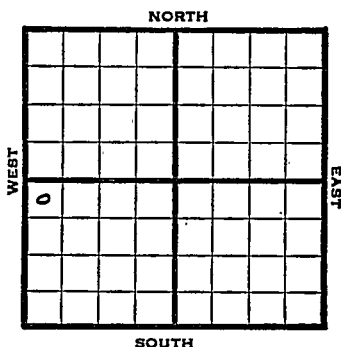

1948 Elev. 1803' REPORT

2/11 10" @ 145'
WOC

2/18 Drlg 1130'

2/25 Arbuckle 3337'
TD 3338'
7" @ 3337
RUST

3/3 "

3/10 TD 3341'
900' oil in 7 hrs.

3/17 Swb. 7 bbls. oil PH

3/24 Arb. 3337'
7" @ 3337'
250 Acid
Pump 40 Pot.
Gr. 41°
TD 3341'

COMPLETED

Map No. _____ Sec. 35 Twp. 19 R. 12W

Well No. 5 Tammen

W. L. Hartman Company

FIRST REPORT Contractor

NW SW

SECTION PLAT

330 Ft. from N. Line

_____ Ft. from S. Line

_____ Ft. from E. Line

330 Ft. from W. Line

0			

Barton County

Location _____

Rig up _____

Drilling and Remarks:

10" @ 145 WOC

RECORD

Cased _____ in., _____ ft.

Sand _____

Gas _____

Oil _____

Total Depth _____

PRODUCTION

1st 24 hrs. Nat. _____

1st 24 hrs. after shot _____

Gas _____ Cu. Ft.

Dry Hole _____

Abandoned _____

Date

FEB 11 1948

19

S. J. LEWIS

Scout

Map No. 46 Sec. 35 Twp. 19 R. 12W

Well No. 5 Panning

W. L. Hartman Company

CORRECTION Contractor

NW SW

SECTION PLAT

330 Ft. from N. Line

 Ft. from S. Line

 Ft. from E. Line

330 Ft. from W. Line

e			

Barton County

Location

Rig up

Drilling and Remarks:

Reported

#5 Tammen

RECORD

Cased in., ft.

Sand

Gas

Oil

Total Depth

PRODUCTION

1st 24 hrs. Nat.

1st 24 hrs. after shot

Gas Cu. Ft.

Dry Hole

Abandoned

Date

FEB 18 1948

19

S. J. LEWIS

Scout

Map No. 46 Sec. 35 Twp. 19 R. 12W

Well No. 5 Panning

W. L. Hartman Company

COMPLETE

Contractor

NW SW


E. 1803
SECTION PLAT

330 Ft. from N. Line

 Ft. from S. Line

 Ft. from E. Line

330 Ft. from W. Line

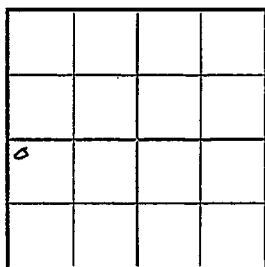

Barton County

Location

Rig up

Drilling and Remarks:

Cr 4332

7" @ 332

2500 feet

Pump 40 P.S.

412 ft

RECORD

Cased in., ft.

Sand

Gas

Oil ✓

Total Depth 3341

PRODUCTION

1st 24 hrs. Nat.

1st 24 hrs. after shot

Gas Cu. Ft.

Dry Hole

Abandoned

Date

MAR 24 1948

19

S. J. LEWIS

Scout