


Section 35 Township 19 Range 12 W

Well No. # 6 Johanning

Company R. E. Hartman

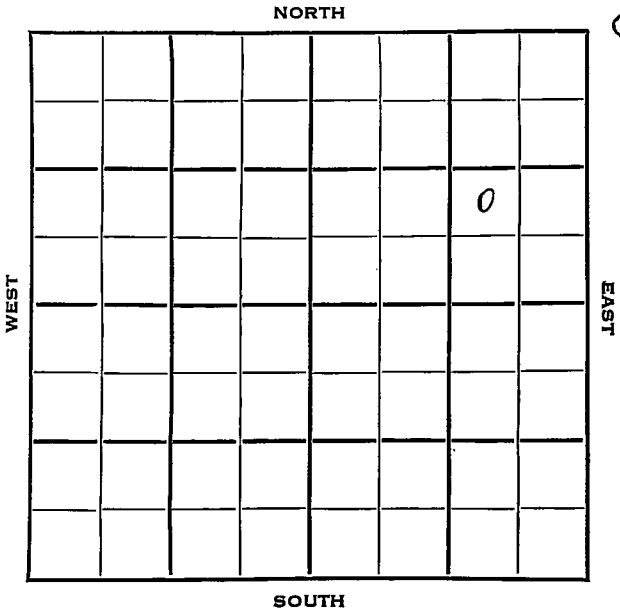


SEC.	TWP.	R.
35	19	1:2W

WELL NO. **6 Johanning** FARM

COMPANY **R. E. Hartman**

CONTRACTOR **H & H Drlg.  
Hammer Pool**

\_\_\_\_\_ Ft. from N. Line  
**990** \_\_\_\_\_ Ft. from S. Line  
**990** \_\_\_\_\_ Ft. from E. Line  
 \_\_\_\_\_ Ft. from W. Line

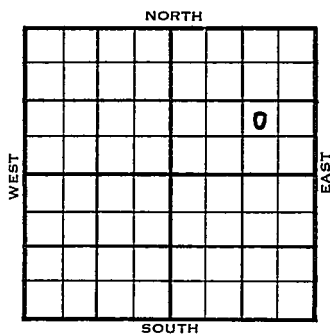

NW SE NE

1953	ELEVATION	REPORT
	1800'	

12/16 Spud 12-10-53  
 8" @ 160'  
 Drlg. 2310'

1954  
 1/20 Spud 12-10-53 Oil well TD 3371  
 8" @ 160 Top 2710 Heeb 2948  
 Tor. 2972 B. Oread 2979' Br line  
 3067' Lans. 3085 Arb. 3340  
 TD 3370 5" @ 3370 DD 3371  
 24/3345-50  
 Comp. 25 BOPD

**COMPLETED**



