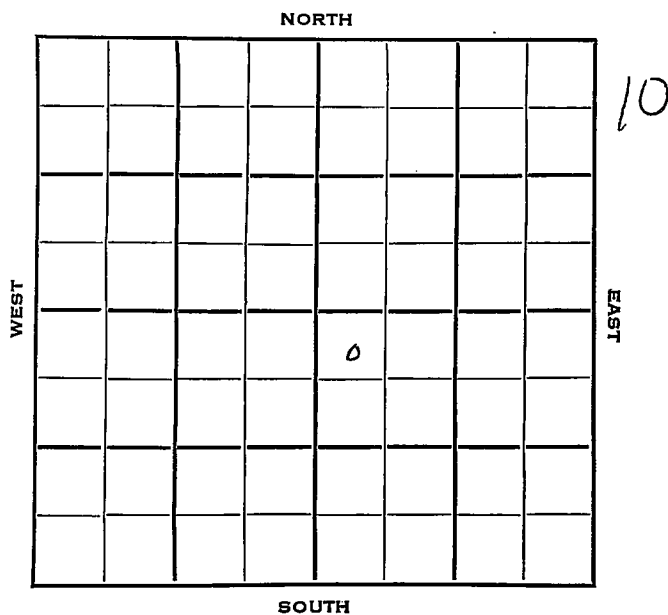


Barton

Section 35 Township 19 Range 12WWell No. #5 PanningCompany Pickrell Drlg.

Barton

KANSAS ✓

Sec. 35 Twp. 19 R. 12WWell No. #5 Panning Farm

Pickrell Drlg.

Company

Pickrell Drlg.

Contractor

Hammer Pool

330

Ft. from N. Line


Ft. from S. Line

Ft. from E. Line

330

Ft. from W. Line

NW NW SE

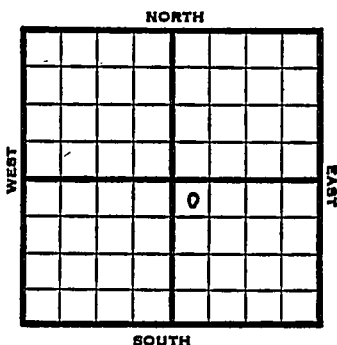

1953

Elev. 1803

REPORT

1/28

Spud 1-15-53

8" @ 150

Anhy 585, Heeb 2449, Br Lime

3065, Lans 3081

Drlg. 3262

2/5

Arb. 3348

RTD 3351

7" @ 3350,

DD 3360, 2 boph 8 hrs., 500A

2/12

DD 3364 TD

S/3½ BOPH, POP

2/18

Spudding Date 1/15/53

O 1 Well TD 3364

8" @ 150 Anhy 585 Heeb. 2449 Br.

Lime 3065 Lans. 3081 Arb. 3348,

TD 3351 7" @ 3350 DD 3360 2 boph 8 h r

500 A DD 3364 S/3½ boph Comp. 50 bopd

COMPLETED

County Barton State KansasSec. 35 (Blk.) 19 (Sur.) 12W Map No. (Twp.)Operator Pickrell Drlg.Well No. 5 Farm PanningElev. Location NW NW SE

330 Ft. From N Line SE330 Ft. From W Line Quarter1st. Report JAN 28 1953Completion Remarks Pickrell Drlg. - Contr.Spudding Date 1-15-53Drlg. Data Hammer Pool8" @ 150 Anhy 585 Heeb. 2449Br. line 3065 Lans. 3081 drlg. 3262

J. G. McGEHEE