


Section 35 Township 19 Range 12W

Well No. #8 Johanning

Company W.I. Hartman

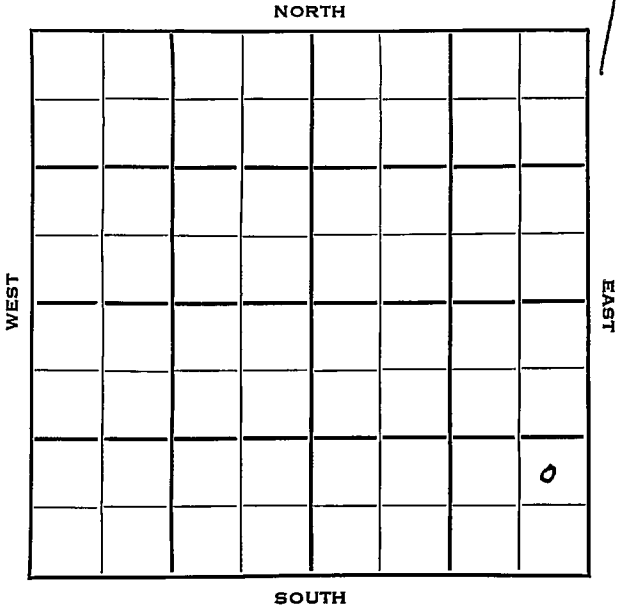

Barton

KANSAS

SEC.	TWP.	R.
35	19	12W ✓

WELL NO. #8 Johanning FARM
 COMPANY

CONTRACTOR W.L. Hartman

H & H Drlg.

Ft. Zarah Pool

NORTH

_____ Ft. from N. Line
 990 _____ Ft. from S. Line
 330 _____ Ft. from E. Line
 _____ Ft. from W. Line

					0

WEST

EAST

SOUTH

NE SE SE

1954	ELEVATION	REPORT
	1801'	

4/21 Spud 4-17-54
 8" @ 168'
 Drlg 1995'

5/5 Top 2706', Heeb 2946', Br li 3065',
 ans 3082', B KC 3224', Cong 3333',
 Arb. 3336'
 RTD 3345'
 5" @ 3336'

5/12 Spud 4-17-54
 Oil Well
 TD 3345'
 8" @ 168'
 Top 2706', Heeb 2946', Br lime 3065',
 Lans 3082', B KC 3224', Cong 3333',
 Arb. 3336'
 TD 3345'
 5" @ 3336'
 GO to 3345', 500A
 Comp. 25 bopd

COMPLETED

County **Barton** State **Kansas**

Sec. **35** (Blk. Twp.) **19** (Sur. Rge.) **12W** Map No.

Operator **W. L. Hartman**

Well No. **8** Farm **Johanning**

Elev. Location **NE SE SE**

FIRST REPORT					
					0

990 Ft. From **S** Line **SE**

330 Ft. From **E** Line Quarter

1st. Report **APR 21 1954**

Completion

Remarks

H & H Drlg. - Contr.

Spudding Date **4-17-54**

Drlg. Data **Ft. Zarah Pool**

8" @ 168 drlg. 1995

