FORM 51

Barton

KANSAS

Section 35 Township 19 Range 12W

Well No. #8 Panning

Company Pickrell Drlg.

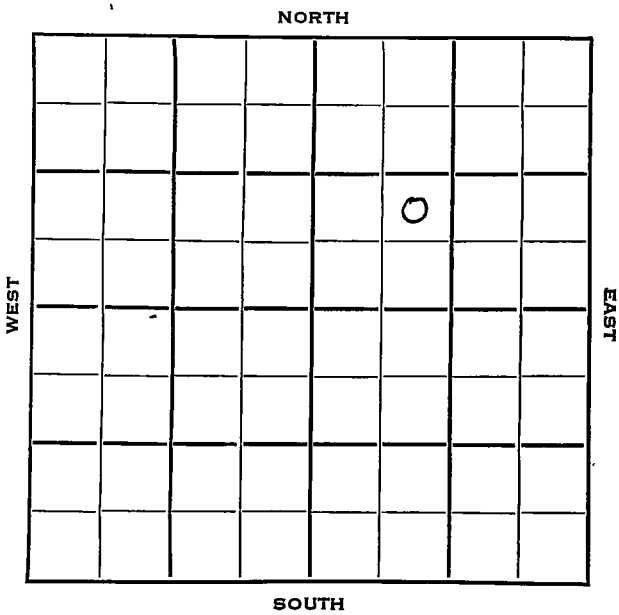

7

Barton KANSAS

SEC.	TWP.	R.
35	19	12W

WELL NO.

#8 Panning FARM

COMPANY

Pickrell Drlg.

CONTRACTOR

Pickrell Drlg.

Hammer Pool

_____ Ft. from N. Line

990 Ft. from S. Line

_____ Ft. from E. Line

990 Ft. from W. Line

NE SW NE

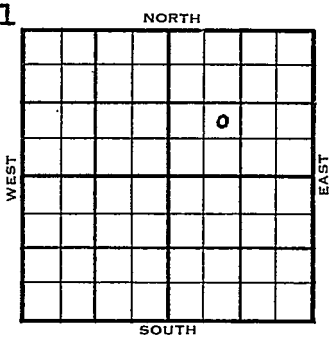

1953	ELEVATION 1801' REPORT
10/7	Spud 10-5-53 8" @ 137' WOC
10/14	Heeb 2949' DST 2921-49', 1 hr, 180' SW Br li 3070' Lans 3084 DST 3089-3125, 1 hr, 70' OCM, 60' HO & GCM, 150' frothy oil, 90' free gassy oil 1120# DST 3128-46, 1 hr, 25' SO & GCW Drlg. 3167'
10/21	Arb. 3340' RTD 3345' 5" @3341'
10/28	NR
11/4	DD 3360' S/3¼ BOPH
11/11	Spud 10-5-53 Oil well TD 3360 8" @ 137 Heeb 2949 DST 2921-49 open 1 hr rec 180' SW Br lime 3070 Lans 3084 DST 3089-3125 open 1 hr rec 70' OCM 60' HO & GCM, 150' frothy oil, 90' free gassy oil, 1120# DST 3128-46 open 1 hr rec 25' SO & GCW Arb. 3340 TD 3345 ~~XXX~~ 5" @ 3341 DD 3360 3-1/4 BOPH P/4 BOPH 8 hr. Comp. 25 BOPD

DX-78

COMPLETED

FORM 275 FOR SALE BY KANSAS BLUE PRINT CO.

County Barton State Kansas

Sec. 35 (Blk. Twp.) 19 (Sur. Rge.) 12W Map No.

Operator Pickrell Drlg.

Well No. 8 Farm Panning

Elev. Location NE SW NE

990 Ft. From S Line NE

990 Ft. From W Line Quarter

1st. Report OCT 7 1953

Completion

Remarks

Pickrell Drlg. - Contr.

Spudding Date 10-5-53

FIRST REPORT

Drlg. Data Hammer Pool

8" @ 137 WOC

J. G. McGEHEE

FORM 275 FOR SALE BY KANSAS BLUE PRINT CO.

County Barton State Kansas

Sec. 35 (Blk. Twp.) 19 (Sur. Rge.) 12W Map No.

Operator Pickrell Drlg.

Well No. 8 Farm Panning

Elev. 1801 Location NE SW NE

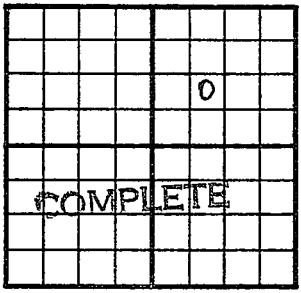

990 Ft. From S Line NE

990 Ft. From W Line Quarter

1st. Report

Completion NOV 11 1953

Remarks Hammer Pool

Pickrell Drlg. - Contr.

Spudding Date 10-5-53

Drlg. Data Oil well TD 3360

8" @ 137 Heeb. 2949 DST 2921-49

open 1 hr. Rec. 180' sw Br. lime 3070

Lans. 3084 DST 3089-3125 open 1 hr.

Rec. 70' ocm 60' ho & gcm 150' frothy

oil 90' free gassy oil 1120#

DST 3128-46 open 1 hr. Rec. 25' so &

gcw Arb. 3340 TD 3345 5" @ 3341

DD 3360 3 1/4 boph P/ 4 boph 8 hr.

Comp. 25 bopd

J. G. McGEHEE