


KANSAS

Rush county

Section 35 Township 19 Range 16-W

Well No. #2, Musolf "B" (Mausolf)

Company Stanolind Oil and Gas Company [?] 2

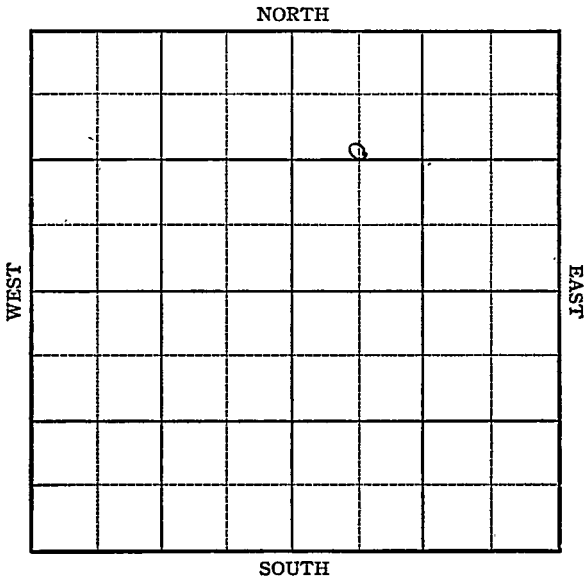

Sec. 35 Twp. 19 R. 16-W

Well No. #2, Musolf "B" Farm

Stanolind Oil and Gas Co. Company

Ryan


1 Ft. from N. Line

1650' Ft. from S. Line

2080' Ft. from E. Line

 Ft. from W. Line

C S L NW NE

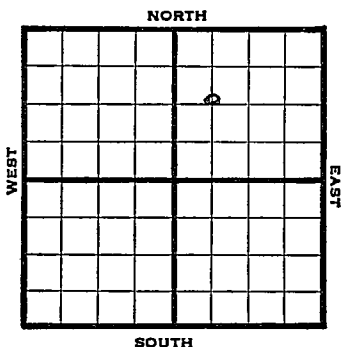

1946 1976 ? REPORT

10/2	R U R
10/8	Anhy 1004- 8" @ 1010 Drlg 1985'
10/15	Drlg 3390'
10/22	Lans 3375' Arb 3639 TD3750' 5" @ 3746, RUST
10/29	- " "
11/6	PB 3725 8 shots 3716-18 500 acid, 3 oil PH
11/12	Sqz Perf.
11/20	PB 3725'
11/27	Arb 3639' 5" @ 3746' TD 3750' Perf Flow 66 POT plus 14% W 39 Grav.

COMPLETED

KANSAS Kansas Pool Name Ryan

Map No. 81 Sec. 35 Twp. 19 R. 16W

Well No. 2 Musolf "B"

Stanolind Company

FIRST REPORT

Contractor

C S L NW NE

SECTION PLAT

_____ Ft. from N. Line

1650 Ft. from S. Line

2080 Ft. from E. Line

_____ Ft. from W. Line

		o	

Rush County

Location _____

Rig up _____

Drilling and Remarks:

R U R

RECORD

Cased _____ in., _____ ft.

Sand _____

Gas _____

Oil _____

Total Depth _____

PRODUCTION

1st 24 hrs. Nat. _____

1st 24 hrs. after shot _____

Gas _____ Cu. Ft.

Dry Hole _____

Abandoned _____

Date

OCT 2 1946 19

S. J. LEWIS Scout

Kansas

Map No. 81 Sec. 35 Twp. 19 R. 16WWell No. 2 Musolf "B"Stanolind Company**COMPLETED** Contractor

C S L NW NE

E. 11976
SECTION PLAT Ft. from N. Line1650 Ft. from S. Line2080 Ft. from E. Line Ft. from W. Line

		o	

Rush County

Location Rig up

Drilling and Remarks:

*Art 3689**5' @ 3746**Prof.**Flow 66 P.D.**+14% N**89-98*

RECORD

Cased in., ft.Sand Gas Oil Total Depth 220~~PRODUCTION~~1st 24 hrs. Nat. 1st 24 hrs. after shot Gas Cu. Ft.Dry Hole Abandoned

Date

NOV 27 1946

19

S. J. LEWIS

Scout