


Section 35 Township 19 Range 16W

Well No. 2 Mausolf

Company Stanolind *IP.*

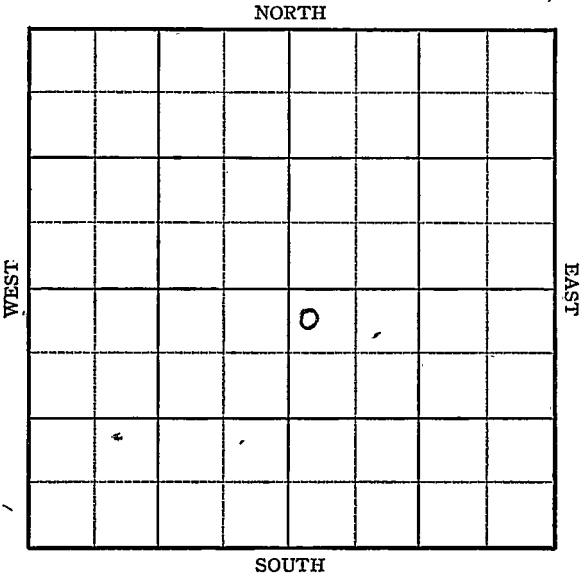

Sec. 35 Twp. 19 R. 16W

Well No. #2 Mausolf Farm

Stanolind Company

Ryan


330 Ft. from N. Line

\_\_\_\_\_ Ft. from S. Line

\_\_\_\_\_ Ft. from E. Line

330 Ft. from W. Line

NW SE Elev. 1988

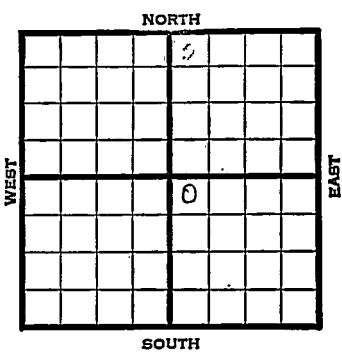

REPORT

1945

7/11

Location

7/19

Anhy 1005  
8" @ 1015' WOC

7/26

Drlg. 2480

8/1

Lans 3395  
Arb. 3664

Drlg. 3667

8/8

TD 3765  
5" @ 3765 RUST

8/15

Plug 3350  
12 shots 3732-3736 1500 acid  
Flow 5 fluid per hr. 45% wtr.

8/22

Squeeze. PB 3750

8/29

500 acid.  
Swb. 1 fluid per hr. 24 hrs. 22% wtr.

9/5

12 shots 3722-3725 500 acid.

9/12

Flow 60 1/2 oil plus 10 1/2 W in 24 hrs.

9/19

Arb. 3664  
5" @ 3765  
Perf. Arb. 2000 acid.  
TD 3765  
Flow 42 oil plus 5 W. Pot.  
Grav. 39.0

. COMPLETED

Kansas Pool Name Ryan

**KANSAS** 81  
 Map No. 81 Sec. 35 Twp. 19 R. 16W

Well No. 2 Mausolf

Stanolind Company

**FIRST REPORT** Contractor

NW SE

**SECTION PLAT**

330 Ft. from N. Line

\_\_\_\_\_ Ft. from S. Line

\_\_\_\_\_ Ft. from E. Line

330 Ft. from W. Line

		o	

Rush County

Location X

Rig up \_\_\_\_\_

Drilling and Remarks:

**RECORD**

Cased \_\_\_\_\_ in., \_\_\_\_\_ ft.

Sand \_\_\_\_\_

Gas \_\_\_\_\_

Oil \_\_\_\_\_

Total Depth \_\_\_\_\_

**PRODUCTION**

1st 24 hrs. Nat. \_\_\_\_\_

1st 24 hrs. after shot \_\_\_\_\_

Gas \_\_\_\_\_ Cu. Ft.

Dry Hole \_\_\_\_\_

Abandoned \_\_\_\_\_

Date

JUL 1 1 1945 19

S. J. LEWIS Scout

**KANSAS**

Pool Name Ryan

**Kansas**

Map No. 81 Sec. 35 Twp. 19 R. 16W

Well No. 2 Mausolf

Stanolind Company

**COMPLETED**

Contractor

NW SE

*E. 11988*  
**SECTION PLAT**

330 Ft. from N. Line

\_\_\_\_\_ Ft. from S. Line

\_\_\_\_\_ Ft. from E. Line

330 Ft. from W. Line


Rush County

Location \_\_\_\_\_

Rig up \_\_\_\_\_

Drilling and Remarks:

*Cor 3664*  
*5" @ 9765*  
*Perfor 8'*  
*2000 acid*  
*Flow 42 oil 15W*  
*Pat*  
*392 gr*

**RECORD**

Cased \_\_\_\_\_ in., \_\_\_\_\_ ft.

Sand \_\_\_\_\_

Gas \_\_\_\_\_

Oil \_\_\_\_\_

Total Depth 9765

**PRODUCTION**

1st 24 hrs. Nat. \_\_\_\_\_

1st 24 hrs. after shot \_\_\_\_\_

Gas \_\_\_\_\_ Cu. Ft.

Dry Hole \_\_\_\_\_

Abandoned \_\_\_\_\_

Date

SEP 19 1945

S. J. LEWIS Scout