


Section 35 Township 19 Range 16W

Well No. 3 Peterson

Company Magnolia


*3*

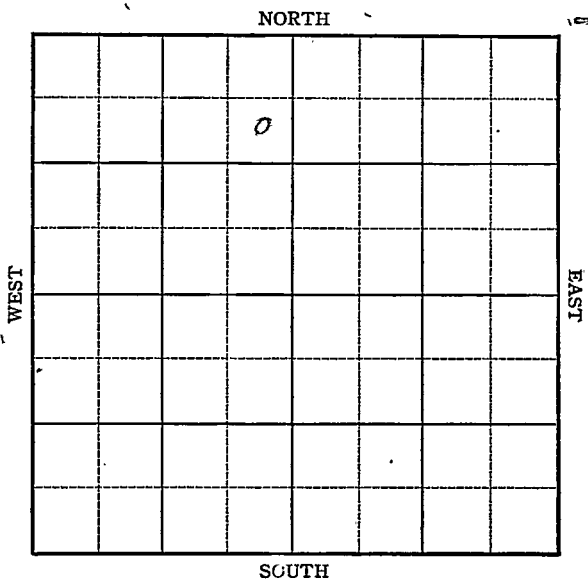

Sec. 35 Twp. 19 R. 16W

Well No. #3 Peterson Farm  
Magnolia Company

990 Ft. from N. Line  
Ft. from S. Line  
330 Ft. from E. Line  
Ft. from W. Line

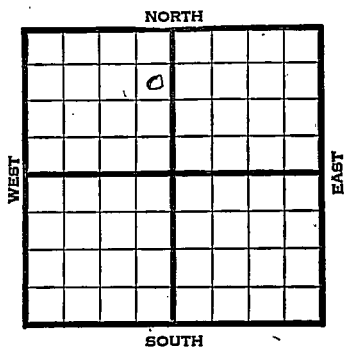

SE NE NW Elev. 1984

1945

REPORT

8/1	Location
8/8/15	Drlg. 3361
8/15	8" @ 1020
	Drlg. 2575
8/22	Drlg. 3370
8/29	Lans 3368
	Arb. 3661
	TD 3715
	5" @ 3713 RUST
9/5	TD 3724 flow 14 oil per hr. 3 hrs.
9/12	Arb. 3661
	5" @ 3713
	500 acid.
	TD 3724
	Flow 344 Pot.
	Grav. 39.0

COMPLETED

**KANSAS**  
Kansas

Pool Name Ryan

Map No. 81 Sec. 35 Twp. 19 R. 16W

Well No. 3 Peterson

Magnolia Company

**FIRST REPORT**

Contractor \_\_\_\_\_

SE NE NW

**SECTION PLAT**

990 Ft. from N. Line

\_\_\_\_\_ Ft. from S. Line

330 Ft. from E. Line

\_\_\_\_\_ Ft. from W. Line

	o		

Rush County

Location X

Rig up \_\_\_\_\_

Drilling and Remarks:

**RECORD**

Cased \_\_\_\_\_ in., \_\_\_\_\_ ft.

Sand \_\_\_\_\_

Gas \_\_\_\_\_

Oil \_\_\_\_\_

Total Depth \_\_\_\_\_

**PRODUCTION**

1st 24 hrs. Nat. \_\_\_\_\_

1st 24 hrs. after shot \_\_\_\_\_

Gas \_\_\_\_\_ Cu. Ft.

Dry Hole \_\_\_\_\_

Abandoned \_\_\_\_\_

Date

AUG 1 1945

19

S. J. LEWIS

Scout

**KANSAS**

Kansas Pool Name Ryan

Map No. 81 Sec. 35 Twp. 19 R. 16W

Well No. 3 Peterson

Magnolia Company

**COMPLETED**

Contractor

SE NE NW

*E. 1, 1984*  
SECTION PLAT

990 Ft. from N. Line

\_\_\_\_\_ Ft. from S. Line

330 Ft. from E. Line

\_\_\_\_\_ Ft. from W. Line

	0		

Rush County

Location \_\_\_\_\_

Rig up \_\_\_\_\_

Drilling and Remarks:

*Cor 83661*  
*5-10-37-13*  
*5000000*  
*Flow 344 B/D*

*87-8-82*

**RECORD**

Cased \_\_\_\_\_ in., \_\_\_\_\_ ft.

Sand \_\_\_\_\_

Gas \_\_\_\_\_

Oil \_\_\_\_\_

Total Depth 3724

**PRODUCTION**

1st 24 hrs. Nat. \_\_\_\_\_

1st 24 hrs. after shot \_\_\_\_\_

Gas \_\_\_\_\_ Cu. Ft.

Dry Hole \_\_\_\_\_

Abandoned \_\_\_\_\_

Date

SEP 12 1945

19

S. J. LEWIS Scout