


Section 35 Township 19 Range 10W

Well No. #5 Peterson

Company Inland Oil
Ryan

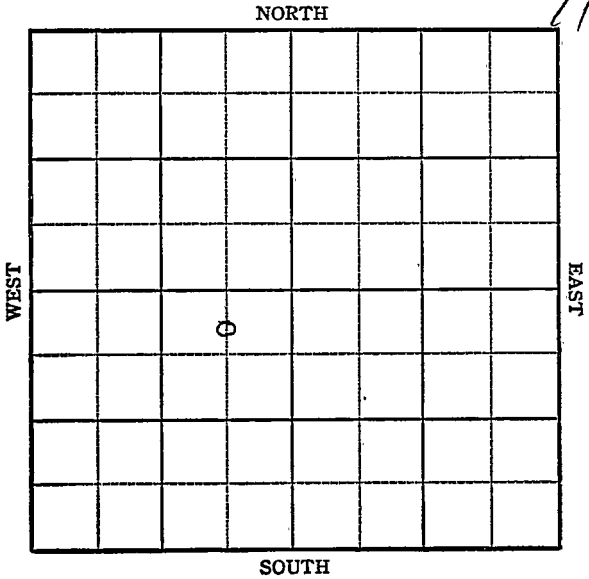

Sec. 35 Twp. 19 R. 16-W ✓

Well No. #5 Peterson Farm _____

Inland Oil Company

Ryan


430 Ft. from N. Line

_____ Ft. from S. Line

660 Ft. from E. Line

_____ Ft. from W. Line

C N L NE SW

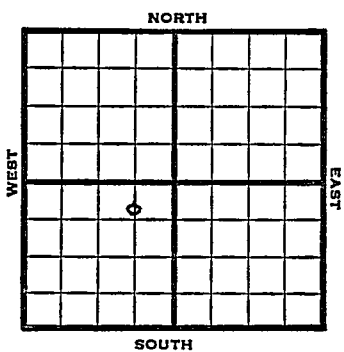

1948

Elev. 1979' REPORT

10/13

Location

10/19

Drlg 850'

10/26

Drlg 2260'

11/3

Drlg. 2380'

11/10

Drlg. 3701'

11/16

"

11/23

"

11/30

Lansing 3390'

Arbuckle 3658'

TD 3775

5" @ 3775'

12/8

"

12/15

23 shots 3710-13

665 acid

12/22

"

12/29

"

1/5

"

1/12

Flow 64 bbls oil 3 hrs / 3% W

1/19

"

1/26

Arb. 3658'

5" @ 3775'

Perf.

650 acid

Pump 103 oil & 32% W Pot.

Gr. 39°

TD 3775'

COMPLETED

Map No. _____ Sec. 35 Twp. 19 R. 16W

Well No. 5 Peterson

Inland Oil Company

FIRST REPORT

Contractor

C N L NE SW

SECTION PLAT

430 Ft. from N. Line

_____ Ft. from S. Line

660 Ft. from E. Line

_____ Ft. from W. Line

	o		

Rush County

Location X

Rig up _____

Drilling and Remarks:

RECORD

Cased _____ in., _____ ft.

Sand _____

Gas _____

Oil _____

Total Depth _____

PRODUCTION

1st 24 hrs. Nat. _____

1st 24 hrs. after shot _____

Gas _____ Cu. Ft.

Dry Hole _____

Abandoned _____

Date

OCT 13 1948 19

S. J. LEWIS Scout

Kansas

Map No. 81 Sec. 35 Twp. 19 R. 16W

Well No. 5 Peterson

Inland Oil Company

COMPLETE

Contractor

C N L NE SW

E. I. 1979
SECTION PLAT

430 Ft. from N. Line

_____ Ft. from S. Line

660 Ft. from E. Line

_____ Ft. from W. Line

	o		

Rush County

Location _____

Rig up _____

Drilling and Remarks:

Art 3658
5" @ 3725
Prof.
65 rods
Pump 103 x 6 1/2
32 1/2 WBT 3998

RECORD

Cased _____ in., _____ ft.

Sand _____

Gas _____

Oil _____

Total Depth 3725

PRODUCTION

1st 24 hrs. Nat. _____

1st 24 hrs. after shot _____

Gas _____ Cu. Ft.

Dry Hole _____

Abandoned _____

Date

JAN 26 1949 19

S. I. LEWIS Scout