

KANSAS


Rush County

FORM 51 5M PETROL

Section 35 Township 19 Range 16W

Well No. 3 Peterson

Company Inland Oil //

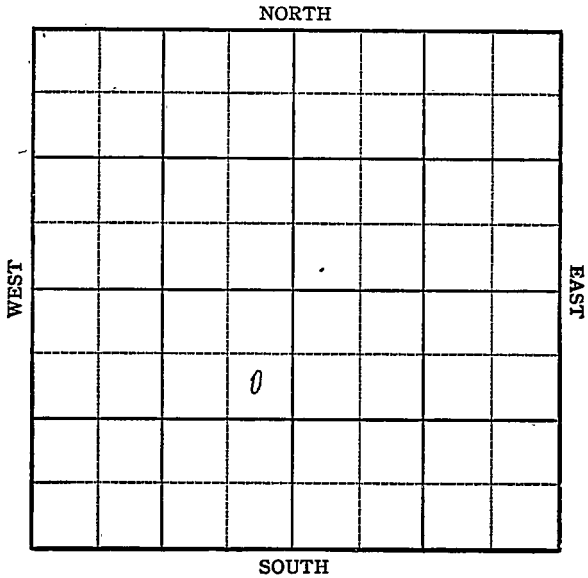

KANSAS

Rush

Sec. 35 Twp. 19 R. 16W

Well No. 3 Peterson Farm

Inland Oil Company


Ryan
990

Ft. from N. Line

Ft. from S. Line

330 Ft. from E. Line

Ft. from W. Line

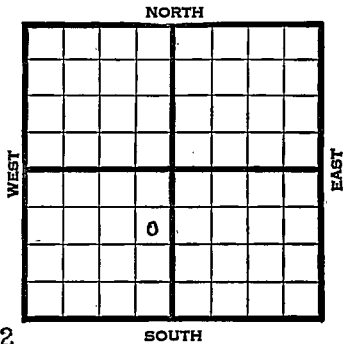

SE NE SW Elev. 1992

1945

REPORT

- | Date | Location |
|------|--|
| 5/23 | Location |
| 5/31 | Drlg. 935 |
| 6/8 | Anhy 1013, 10" @ 1020 Drlg.-
2461 |
| 6/14 | Lams 3386
Drlg. 3471 |
| 6/21 | " " |
| 6/28 | 12 shots 3731-33 950' W & 400' oil
1 hr PB 3729
23 shots 3721-28 |
| 7/3 | 39 shots 3715-3719
1000 acid, 12 M. Gas |
| 7/11 | " " " " " |
| 7/19 | Flow & fluid PH 25% water- 12 hrs. |
| 7/26 | " " " " " |
| 8/15 | Arb. 3661
5" @ 3770
Perf. Arb. 2250 acid
TD 3770
Pump 77 oil plus 24% wtr. Pot
Grav. 39.0 |

COMPLETED

Kansas Pool Name Ryan

Map No. 81 Sec. 35 Twp. 19 R. 16W

Well No. 3 Peterson

Inland Oil Company

FIRST REPORT Contractor

SE NE SW

SECTION PLAT

990 Ft. from N. Line

_____ Ft. from S. Line

330 Ft. from E. Line

_____ Ft. from W. Line

Rush County

Location X

Rig up _____

Drilling and Remarks:

RECORD

Cased _____ in., _____ ft.

Sand _____

Gas _____

Oil _____

Total Depth _____

PRODUCTION

1st 24 hrs. Nat. _____

1st 24 hrs. after shot _____

Gas _____ Cu. Ft.

Dry Hole _____

Abandoned _____

Date

MAY 23 1945

19

S. J. LEWIS

Scout

KANSAS

Kansas Pool Name RyanMap No. 81 Sec. 35 Twp. 19 R. 16WWell No. 3 PetersonInland Oil Company**COMPLETED**

Contractor

SE NE SW

E 11992
SECTION PLAT990 Ft. from N. Line Ft. from S. Line330 Ft. from E. Line Ft. from W. Line

Rush CountyLocation Rig up

Drilling and Remarks:

Cor 83661
5" @ 3770
Prof out
2250 acid
Pump 77 oil + 24 1/2
Water out

RECORD

Cased in., ft.Sand Gas Oil Total Depth 3770

PRODUCTION

1st 24 hrs. Nat. 1st 24 hrs. after shot. Gas Cu. Ft.Dry Hole Abandoned

Date

8-9-45

AUG 15 1945 19

S. J. LEWIS Scout