


Section 35 Township 19 Range 16W

Well No. #4 Peterson

Company Magnolia  
Ryan Pool

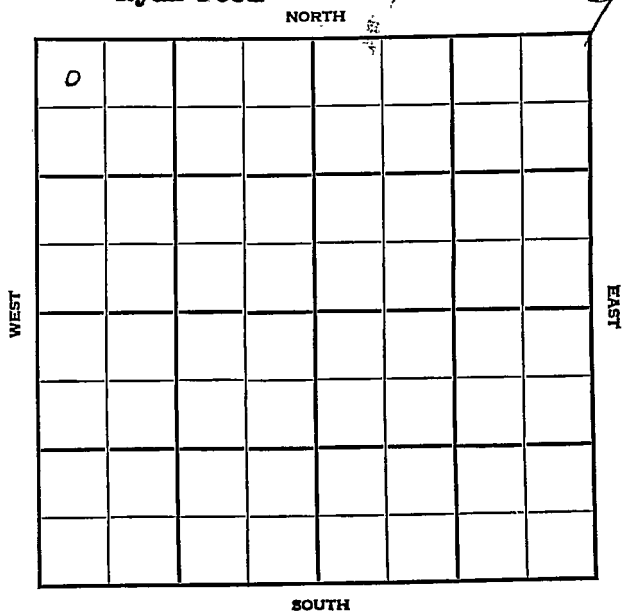

Sec. 35 Twp. 19 R. 16W

Well No. #4 Peterson Farm


Magnolia Company  
Ryan

330 Ft. from N. Line

\_\_\_\_\_ Ft. from S. Line

\_\_\_\_\_ Ft. from E. Line

330 Ft. from W. Line

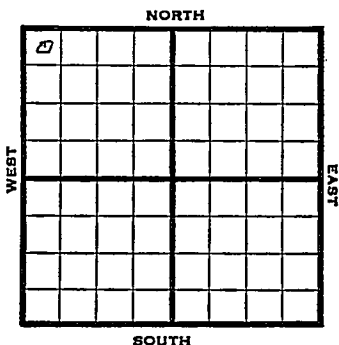

NW/C

1948

Elev. 2000'

REPORT

4/7 Location

4/14 "

4/21 Drlg. 3200'

4/28 Arbuckle 3679'  
TD 3733'  
5" @ 3730'  
RUST

5/5 1500 acid  
Flow 12 bbls. oil in 8 hrs.

5/12 Arb. 3679'  
5" @ 3730'  
Flow 397 oil Pot  
39.0 Gr.  
TD 3733'  
Comp.

**COMPLETED**

Map No. \_\_\_\_\_ Sec. 35 Twp. 19 R. 16W

Well No. 4 Peterson

Magnolia Company

FIRST REPORT

Contractor

NW/C

SECTION PLAT

330 Ft. from N. Line

\_\_\_\_\_ Ft. from S. Line

\_\_\_\_\_ Ft. from E. Line

330 Ft. from W. Line

0			

Rush County

Location X

Rig up \_\_\_\_\_

Drilling and Remarks:

RECORD

Cased \_\_\_\_\_ in., \_\_\_\_\_ ft.

Sand \_\_\_\_\_

Gas \_\_\_\_\_

Oil \_\_\_\_\_

Total Depth \_\_\_\_\_

PRODUCTION

1st 24 hrs. Nat. \_\_\_\_\_

1st 24 hrs. after shot \_\_\_\_\_

Gas \_\_\_\_\_ Cu. Ft.

Dry Hole \_\_\_\_\_

Abandoned \_\_\_\_\_

Date

APR 7 1948 19 \_\_\_\_\_ S. J. LEWIS Scout

Map No. 81 Sec. 35 Twp. 19 R. 16W

Well No. 4 Peterson

Magnolia Company

COMPLETE Contractor

NW/C

E1, 2000  
SECTION PLAT

330 Ft. from N. Line

\_\_\_\_\_ Ft. from S. Line

\_\_\_\_\_ Ft. from E. Line

330 Ft. from W. Line

6			

Rush County

Location \_\_\_\_\_

Rig up \_\_\_\_\_

Drilling and Remarks:

*Cor 3679*

*51289730*

*Flow 397 oil*

*BT*

*397 oil*

RECORD

Cased \_\_\_\_\_ in., \_\_\_\_\_ ft.

Sand \_\_\_\_\_

Gas \_\_\_\_\_

Oil  \_\_\_\_\_

Total Depth 3239

PRODUCTION

1st 24 hrs. Nat. \_\_\_\_\_

1st 24 hrs. after shot \_\_\_\_\_

Gas \_\_\_\_\_ Cu. Ft.

Dry Hole \_\_\_\_\_

Abandoned \_\_\_\_\_

Date

MAY 12 1948 19

S. J. LEWIS Scout